


STATION TS KINGSGATE A & B
10000 & 10001

Owners Name: HAYES, KINGSGATE HOTEL Current Occupant:


Address: WILLIAM ST Address:

KINGS CROSS
11-6-1975

Access See caretaker of building for access to 34th floor.

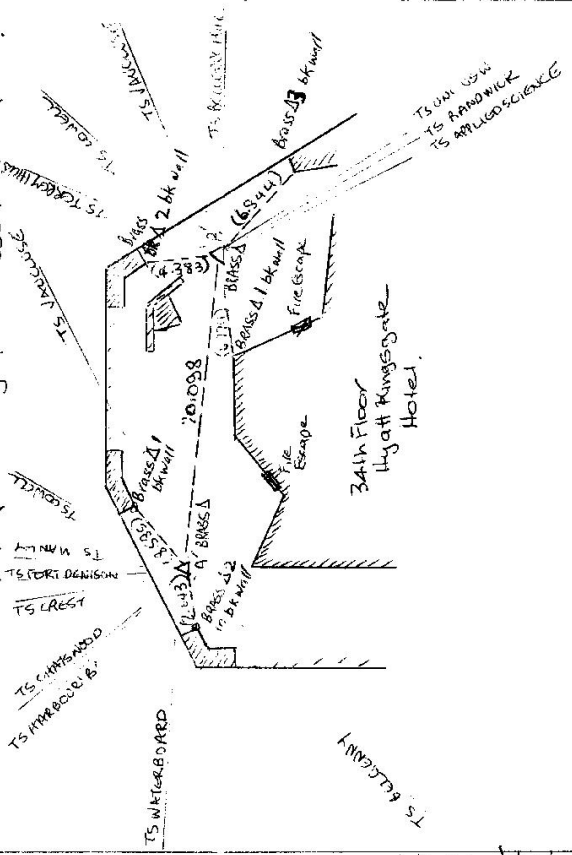

Scale

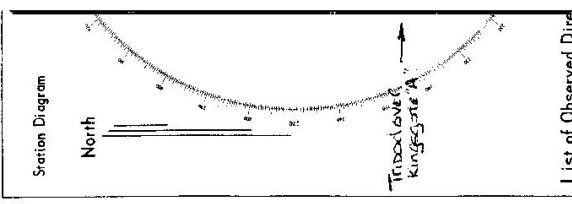

List of Observed Dire

Station	Direction	Station	Direction
TS WATERBOARD	0° 00' 00"	TS KINGSGATE A	0° 00' 00"
TS CARISWOOD	62° 38' 47"	TS KINGSGATE B	0° 00' 00"
BRASS 1	84° 49' 03"	TS CONWELL	0° 00' 00"
BRASS 2	328° 48' 46"	TS BELLEVUE HILL	68° 01' 56"
TS KINGSGATE B	202° 24' 10"	BRASS 1	239° 25' 54"
		BRASS 2	317° 02' 27"
		BRASS 3	141° 07' 25"
		BRASS 4	245° 14' 41"

D. West, Government Printer, New South Wales - 1976