

7.5 m

Department of Lands
Integr.: Survey of N.S.W.

RECONNAISSANCE and MAINTENANCE REPORT

STATION **7S CREST** 10002
 Co: **CLM BERRI ARAD Pt. CITY OF SYDNEY**
 Map Sheet: **SYDNEY** No: **1845**
 Inspected by: **J. H. FLETCHER** Date: **30.6.18**
 Authority: **DEPT. OF LANDS** Field Book: **352**

Beacon Diagram
Not to Scale

This Trig. Station has been: Note: Cross out word or words which do not apply

1. Completely cleared to permit 360° vision to surrounding Trigs.
2. Cleared by lanes bearing from Trig. Mast
3. Trig. Mast & Vanes have been painted white & black respectively.
4. The Trig. was unpiled/not unpiled, dimensions now being:

Description of mark: ***NAIL IN CONCRETE** should be explicit, e.g. Steel plug, Brass plug, Bot. Concrete Pillar
 Height of mark: **above rock, concrete** m below G.L.
 * (THIS REPORT REQUIRES THAT THIS IS WHAT CAN RECORD)

Height of Top Vanes to Top Mark/Top pillar plate: m Diameter of Vanes (vertical): m.
 Height of Cairn: m Diameter of Cairn: m.
 Length of Mast: m. (approximate if not unpiled)

5. A **CONCRETE** set in conc./soil has been placed/fd 4.077 m. bearing 85.15° M from Trig. ~~Mast/pillar~~
6. A set in conc./soil has been placed/fd m. bearing m. from Trig. Mast/pillar
7. A set in conc./soil has been placed/fd m. bearing m. from Trig. Mast/pillar
8. A set in conc./rock has been placed/fd m. bearing m. from Trig. Mast/pillar

9. Connection: to: m. bearing m.
10. Connection: to: m. bearing m.

11. Connection: to: m. bearing m.
12. Connection: to: m. bearing m.

13. Diff. Ht. **SEPARATE** is **CG4** m. above/below **MAINTENANCE**
14. Diff. Ht. is m. above/below

15. Diff. Ht. is m. above/below
16. Diff. Ht. is m. above/below

Prepared by: [Signature] Checked: [Signature]

Date	Record of Station

NO BEACON.


STATION 10002 TS CREST

Owners Name CREST HOTEL Current Occupant.....


Address 111 PARLIAMUNST RD Address.....

KINGS CROSS

Access

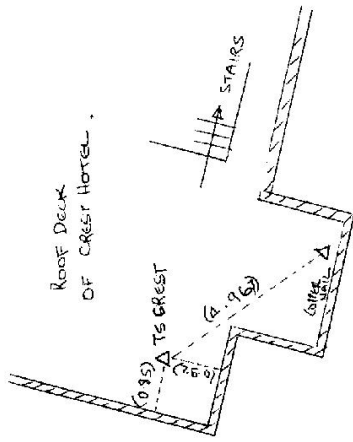

SEE CARETAKER OF HOTEL FOR ACCESS TO ROOFTOP.

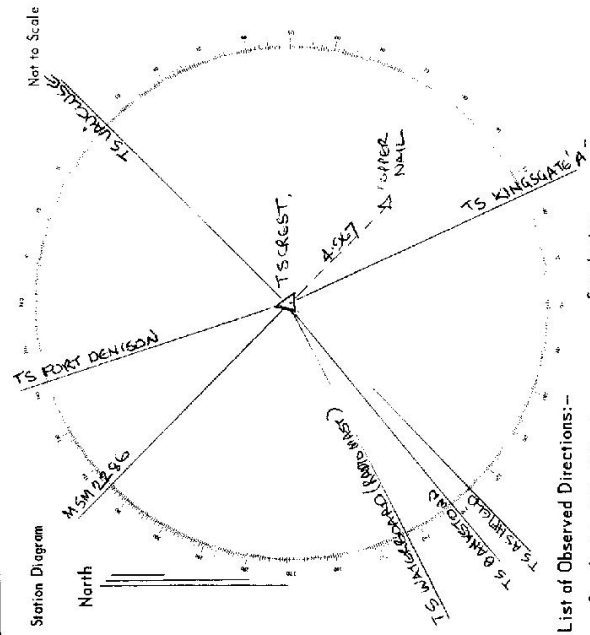

List of Observed Directions:-

Standpoint: TS CREST		Standpoint:	
Station	Direction	Station	Direction
TS WATERBORD MAST	10° 00' 00"	TS ASHFIELD	343° 46' 43"
MSM 22.16	73° 18' 38"	TS BANKSTOWN	345° 02' 28"
TS FORT DENISON	98° 57' 49"	COPPER NAIL	751° 38' 21"
TS VANCLUSE	164° 07' 22"		
TS KINGSGATE 'A'	270° 51' 30"		
STANDPOINT AT COPPER NAIL		STANDPOINT AT COPPER NAIL	
Station	Direction	Station	Direction
TS WATERBORD MAST	10° 00' 00"		
TS CREST	71° 28' 00"		
TS NAUCLUSE	184° 02'		