
This Trig. Station has been:-	RECONNAISSANCE and MAINTENANCE REPORT	STATION TS BELGENNY 10003
	Note: Cross out word or words which do not apply	BERLAND Phi CITY
	vision to surrounding Trigs.	Inspected by J. F. P. Leteral Date: 25.675
2. Cleared by lanes bearing.	from Trig. Mast	v
3. Trig. Mast & Vanes have been painted white & black respectively.	8 black respectively.	
4. The Trig. was unpiled/not unpiled, dimensions now being: Description of mark. D.Q.X.S. L. 112. Kovy F sh	d, dimensions now being: بیک الاحصاف Balı, Concrete Pillar الاحمان المالية المالية المالية المالية المالية المالية المالية المالية المال	
Height of mark	rock/concrete means 6.L.	
Height of lop Vanes to lop Mark/lop pillar Height of Cairn	Height of Lop Vanes to Lop Mark Lop pillar plate	
	piled)	N> BEARD
5. A. D.H fset in concreck has been plac	5. A. D.H	
6. A. D.H. Z. set in conc/soi l has been plac	A. D.H Zset in concisori l has been placed fd <i>A. A.Q.</i> m. bearing	
7. A. D.H. 3set in concrete has been place	7. A. D.H. 3set in concretion! has been placed fd S. 26cm. bearing2.4	
8. A	:ed/fdm. bearing	
9. Connectionto		
10. Connection to	: m. bearing	
11. Connectiontotototobearing	m. beering	Date Record of Station
	Ĕ.	
13. Diff. Ht. Daru Marte I. is. 0.17. m. above	m. BRASS A. In 1094	
14. Diff. Hr. D. River Hove. 2. is 0.52 m. above	m, deove I) X 	
15. Diff. H. P.A.N.L. Hole S. is O.I.J. m. obve	m. above K 19	
16. Diff. Ht is	detore Machove	

١____

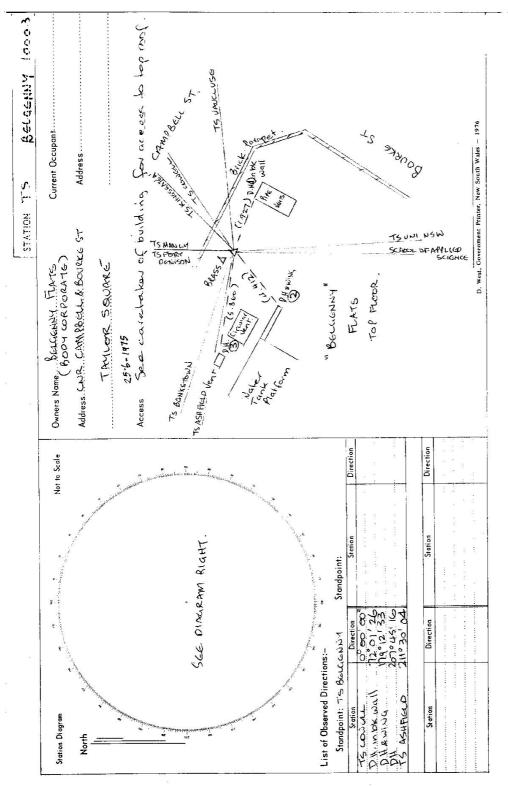

......