


Department of Lands
 Integral Survey of N.S.W.
 RECONNAISSANCE and MAINTENANCE REPORT 10006 STATION CRESVIEW 75 10006

Co: CUMBERLAND Ph: WILLOUGHBY
 Map Sheet: MOSMAN No: 1852
 Inspected by: F.J. SULLIVAN Date: 9.12.1975
 Authority: LANDS DEPT Field Book:

Beacon-Diagram: Not to Scale

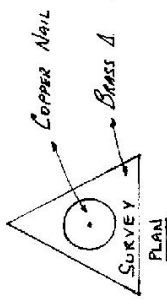

MARK IS AS SHOWN ABOVE SET INTO THE CONCRETE ROOF WITH PANEL METAL.

This Trig. Station has been:-

1. ~~Completed to permit 360° vision to surrounding trig.~~
2. Cleared by lanes bearing 251° 49' to 151° 04' from Trig. Mast
3. Trig. Mast & Vanes have been painted white & black respectively.
4. ~~The Trig. was unplied not unplied, dimensions now being:-~~

Description of mark: Copper Nail in Brass A should be explicit, e.g. Steel plug, Brass plug, Bolt, Concrete Pillar
 Height of mark: 0.00 m above rock concrete roof m above G.L.
 Height of Top Vanes to Top Mark/Top pillar plate: m Diameter of Vanes (vertical): m
 Height of Cairn: m. Diameter of Cairn: m.

- Length of Mast: m. (approximate if not unplied)
5. A set in conc/rock has been placed/rd m. bearing°M from Trig. Mast/pillar
 6. A set in conc/soil has been placed/rd m. bearing°M from Trig. Mast/pillar
 7. A set in conc/soil has been placed/rd m. bearing°M from Trig. Mast/pillar
 8. A set in conc/rock has been placed/rd m. bearing°M from Trig. Mast/pillar

9. Connection: to m. bearing°M
10. Connection: to m. bearing°M
11. Connection: to m. bearing°M
12. Connection: to m. bearing°M
13. Diff. Ht. is m. ^{above}/_{below}
14. Diff. Ht. is m. ^{above}/_{below}
15. Diff. Ht. is m. ^{above}/_{below}
16. Diff. Ht. is m. ^{above}/_{below}


Prepared by: F.J. SULLIVAN Checked: [Signature]

Date	Record of Station
4-3-75	Mark Placed


STATION CRESTVA 75 10006

Owners Name LEON RATS SOY
CRESTVIEW UNITS
 Address 180 SPY RD
 Current Occupant.....
 Address.....

MOSMAN
9-12-1975
 Access "CRESTVIEW" UNITS No 180 SPY ROAD MOSMAN.
 MAKE YOURSELF KNOWN TO ONE OF THE COMMITTEE MEMBERS AT THE UNITS. A KEY IS NEEDED FOR ACCESS TO THE ROOF. PROCEED TO 2ND FLOOR, WALK UP ONE FLIGHT OF STAIRS AND EXIT TO ROOF VIA DOOR.

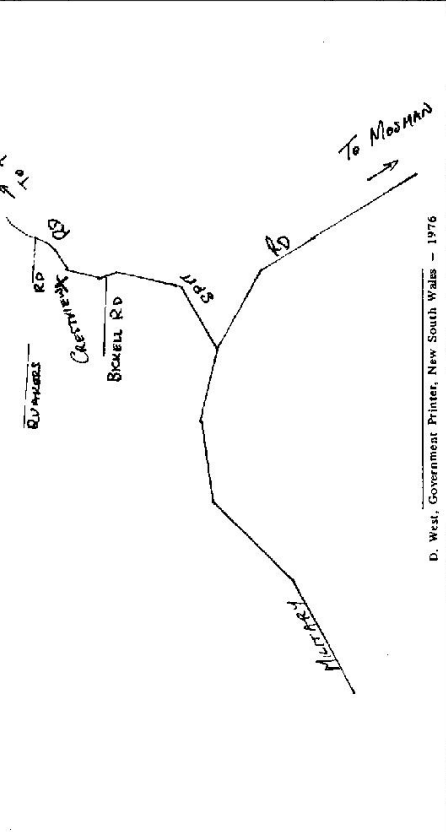

D. West, Government Printer, New South Wales - 1976

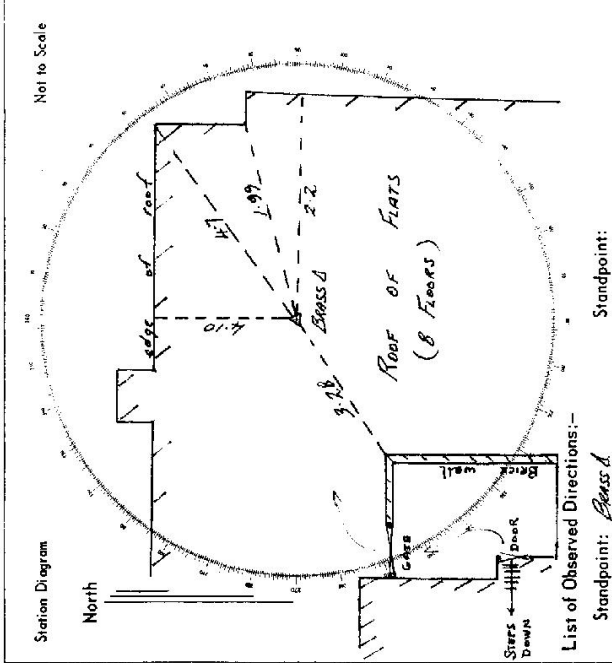

List of Observed Directions:-

Standpoint: Beards

Station	Direction	Station	Direction
<u>MANNY T.S</u>	<u>16 06 22</u>		
<u>COUNCIL REAR</u>	<u>88 15 42</u>		
<u>VARIABLE LIGHTHOUSE</u>	<u>137 28 02</u>		
<u>VARIABLE REAR</u>	<u>149 36 48</u>		
<u>KINGSWOOD PILLAR</u>	<u>172 22 22</u>		

Station	Direction	Station	Direction
<u>KINGSWOOD P</u>	<u>220 08 45</u>		
<u>FOREST REAR</u>	<u>347 33 04</u>		
<u>BAYVIEW REAR</u>	<u>355 30 51</u>		