



Department of Lands Integration Survey of N.S.W. RECONNAISSANCE and MAINTENANCE REPORT 10020 Note: Cross out word or words which do not apply	STATION MALDON No: _____ Date: APRIL 75 Authority DEPT OF LANDS Field Book: 684 39 Not to Scale	Beacon Diagram
This Trig. Station has been:- 1. Completely cleared to permit 360° vision to surrounding Trigs. 2. Cleared by lanes bearing from Trig. Mast 3. Trig. Mast & Vanes have been painted white & black respectively. 4. The Trig. was unpiled/not unpiled, dimensions now being:	Description of mark CONCRETE CHIMNEY should be explicit, e.g. Steel plug, Brass plug, Ball, Concrete Pillar Height of mark m ^{above} rock/concrete 58.52 m ^{above} G.L. Height of Top Vanes to Top Mark/Top pillar plate m Diameter of Vanes (vertical) m. Height of Cairn m. Diameter of Cairn m.	Length of Mast m. (approximate if not unpiled) 5. A. B.T. set in ^{CHIMNEY} concrete has been placed N. 1.98 m. bearing 312°M from CHIMNEY CENTRE 6. A. Dumpty (1) set in conc/soil has been placed N. 1.152 m. bearing 312°M from CHIMNEY CENTRE 7. A. Dumpty (2) set in conc/soil has been placed N. 8.255 m. bearing 53°M from CHIMNEY CENTRE 8. A. set in conc/rock has been placed td m. bearing°M from Trig. Mast/pillar 9. Connection B.T. to Dumpty (1) : 12.172 m. bearing°M 10. Connection B.T. to Dumpty (2) : 7.693 m. bearing°M 11. Connection Dumpty (1) to Dumpty (2) : 13.295 m. bearing°M 12. Connection to : m. bearing°M 13. Diff. Ht. : is m. ^{above} _{below} 14. Diff. Ht. : is m. ^{above} _{below} 15. Diff. Ht. : is m. ^{above} _{below} 16. Diff. Ht. : is m. ^{above} _{below}
Prepared by: Barbara		Checked: St. Dunlop
Date _____		Record of Station _____

STATION MALDON / TS 10020

Owners Name.....
 Current Occupant.....

Address.....
 Address.....

Access April 1970
 Not to Scale

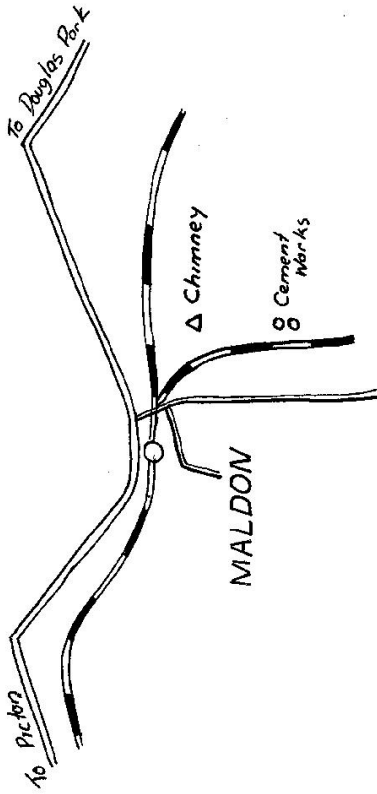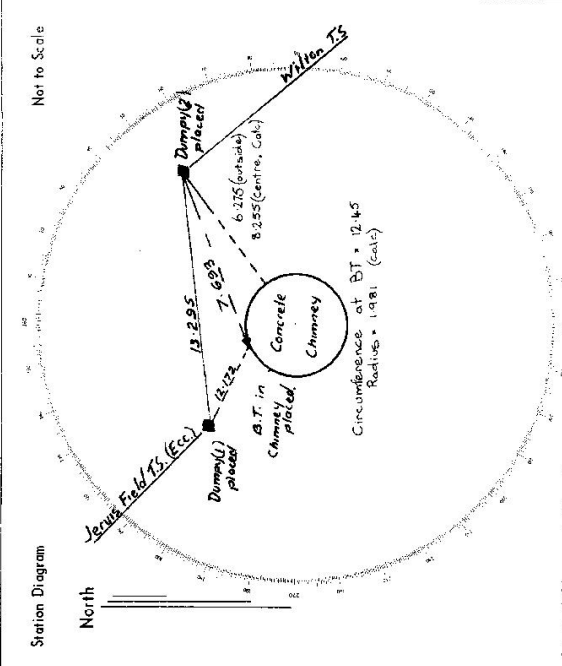

List of Observed Directions:-

Station		Direction		Station		Direction	
Standpoint: Dumpy (U)				Standpoint: Dumpy (C)			
JEARNS FIELD TS (ECC)	359° 59' 40"	WILTON TS	359° 59' 40"				
DUMPY NO. 2	182° 02' 13.5"	CHIMNEY LHS	59° 11' 50"				
CHIMNEY LHS	168° 49' 05"	SCORCH ON CHIMNEY - CHIMNEY CENT	72° 57' 23.5"				
B.T.	176° 50' 47"	CHIMNEY R.H.S	86° 43' 14"				
CHIMNEY RHS	184° 52' 08"	Dumpy (U)	157° 14' 38"				
Station				Station			
CENTRE CHIMNEY	178° 50' 36"	B.T.	86° 40' 01"				