

75 103

Department of Lands
 Integrati survey of N.S.W.
RECONNAISSANCE and MAINTENANCE REPORT

STATION TS 10024 PITTWATER RADIO MAST
 Co: CUMBERLAND Ph: NARRABEEN
 Map Sheet: TERRY HILLS No: U18G.7
 Inspected by: D VINCENT Date: 24.7.73
 Authority Integration Surveys Field Book: A.B. 1332

This Trig. Station has been: *Note: Cross out word or words which do not apply*


1. Completely cleared to permit 360° vision to surrounding Trigs.
2. Cleared by lanes bearing..... from Trig. Mast
3. Trig. Mast & Vanes have been painted white & black respectively.
4. The Trig. was unpiled/not unpiled, dimensions now being:

Description of mark..... should be explicit, e.g. Steel plug, Brass plug, Bolt, Concrete Pillar
 Height of mark..... m above below rock, concrete m above below G.L.
 Height of Top Vanes to Top Mark/Top pillar plate..... m Diameter of Vanes (vertical)..... m.
 Height of Cairn..... m Diameter of Cairn..... m.

- Length of Mast..... m. (approximate if not unpiled)
5. A Drill hole set in conc/rock has been placed/rd 3.802 m. bearing 317°M from Trig. Mast/pillar
 Radio mast
 6. A..... set in conc/soil has been placed/rd..... m. bearing.....°M from Trig. Mast/pillar
 7. A..... set in conc/soil has been placed/rd..... m. bearing.....°M from Trig. Mast/pillar
 8. A..... set in conc/rock has been placed/rd..... m. bearing.....°M from Trig. Mast/pillar

9. Connection..... to..... m. bearing.....°M
10. Connection..... to..... m. bearing.....°M
11. Connection..... to..... m. bearing.....°M
12. Connection..... to..... m. bearing.....°M
13. Diff. Ht. Drill hole is 2.74 m. above below
 Diff. Ht. is..... m. above below
14. Diff. Ht. is..... m. above below
15. Diff. Ht. is..... m. above below
16. Diff. Ht. is..... m. above below

Prepared by: Checked:

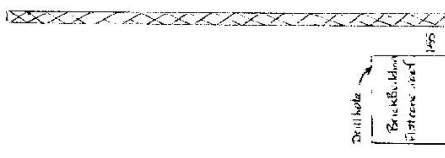


Date: Record of Station


STATION TS 10024 PITWATER RADIO MAST

Owners Name: MWS & D
 Current Occupant:

Address:

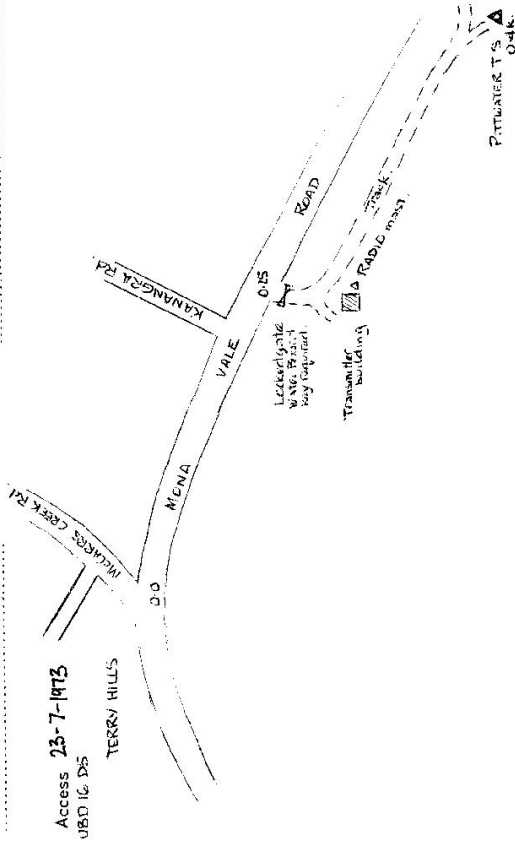

Net to Scale

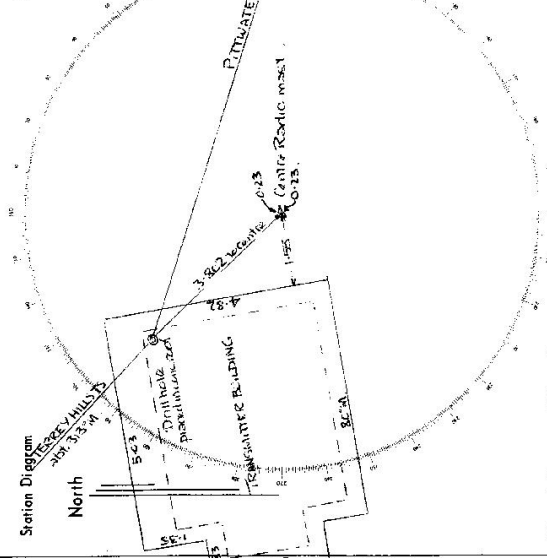

List of Observed Directions:-

Station		Standpoint:	
Station	Direction	Drill hole	Station
TS TERRY HILLS	070 00		
TS PITWATER	154 30 43		
Centre Radio Mast (236)	183 58 40		
Station	Direction	Station	Direction