



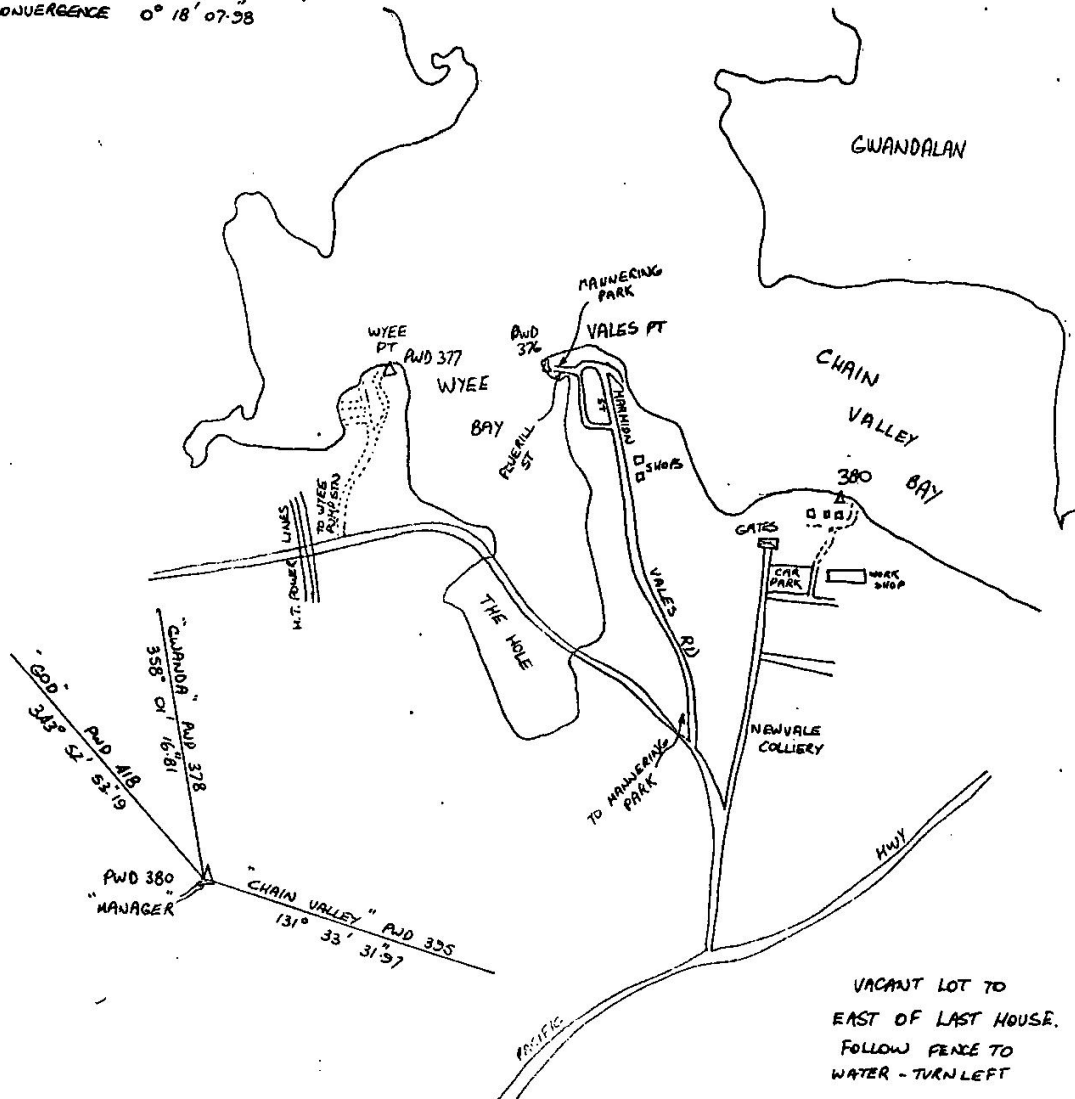
P.W.D. SURVEY MARK SK

TS10032

Parish County City or Town VALES PT.
 Municipality or Shire LAKE MACQUARIE

CO-ORDINATES

GRID	ZONE	CM	METRES		YARDS	
			E	N	E	N
AMG						
ISG	56/1		351 535.143	1 329 426.221		
ANG						
LOCAL						

CONVERGENCE $0^{\circ} 18' 07.98''$ Measurements are in METRESPlaced in connection with LAKE MACQUARIE HYDRO SURVEY

Field Books Level Books

Reduced Level of Mark 1.421 (prov.) To Datum A.H.D.Origin of Levels B.M. 1908 H.D.W.B. Reduced Level of Origin 29.780 (prov)Date: 30/3/76 ... Signature T.H. Rogers ...

01110 200