


From : John Cassidy
Survey Control Branch (Wyang)
Ph 043 531333 Ext 244

Trig Access

TS 10051 (PWD 374)

9 December 1994

- 0.0 Intersection Pacific Hwy and Wallarah Colliery Entrance
- 0.5 Wallarah Colliery Main Office. Obtain key for locked gate. Head back towards Highway.
- 0.85 "Y" intersection, turn hard left to loading bin.
- 1.15 Bridge over conveyor.
- 1.2 Thru locked gate, turn left.
- 1.55 "+" intersection go straight ahead.
- 1.8 "Y" intersection, keep to right.
- 2.2 Track to left, go straight ahead.
- 2.4 TS 10051

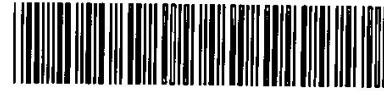

TS10051

Trig Access

TS 10051 (PWD 374)

9 December 1994

- 0.0 Intersection Pacific Hwy and Wallarah Colliery Entrance
- 0.5 Wallarah Colliery Main Office. Obtain key for locked gate. Head back towards Highway.
- 0.85 "Y" intersection, turn hard left to loading bin.
- 1.15 Bridge over conveyor.
- 1.2 Thru locked gate, turn left.
- 1.55 "+" intersection go straight ahead.
- 1.8 "Y" intersection, keep to right.
- 2.2 Track to left, go straight ahead.
- 2.4 TS 10051

From :

John Cassidy
Survey Control Branch (Wyang)
Ph 043 531333 Ext 244

PWD NO 374


P.W.D. SURVEY MARK SKETCH PLAN

Parish County City or Town RATHMINES
 Municipality or Shire

CO-ORDINATES

GRID	ZONE	CM	METRES		YARDS	
			E	N	E	N
AMG						
ISG	56/1		3 55 710.424	1 330 870.078		
ANG						
LOCAL						

CONVERGENCE 0° 19' 35" 54

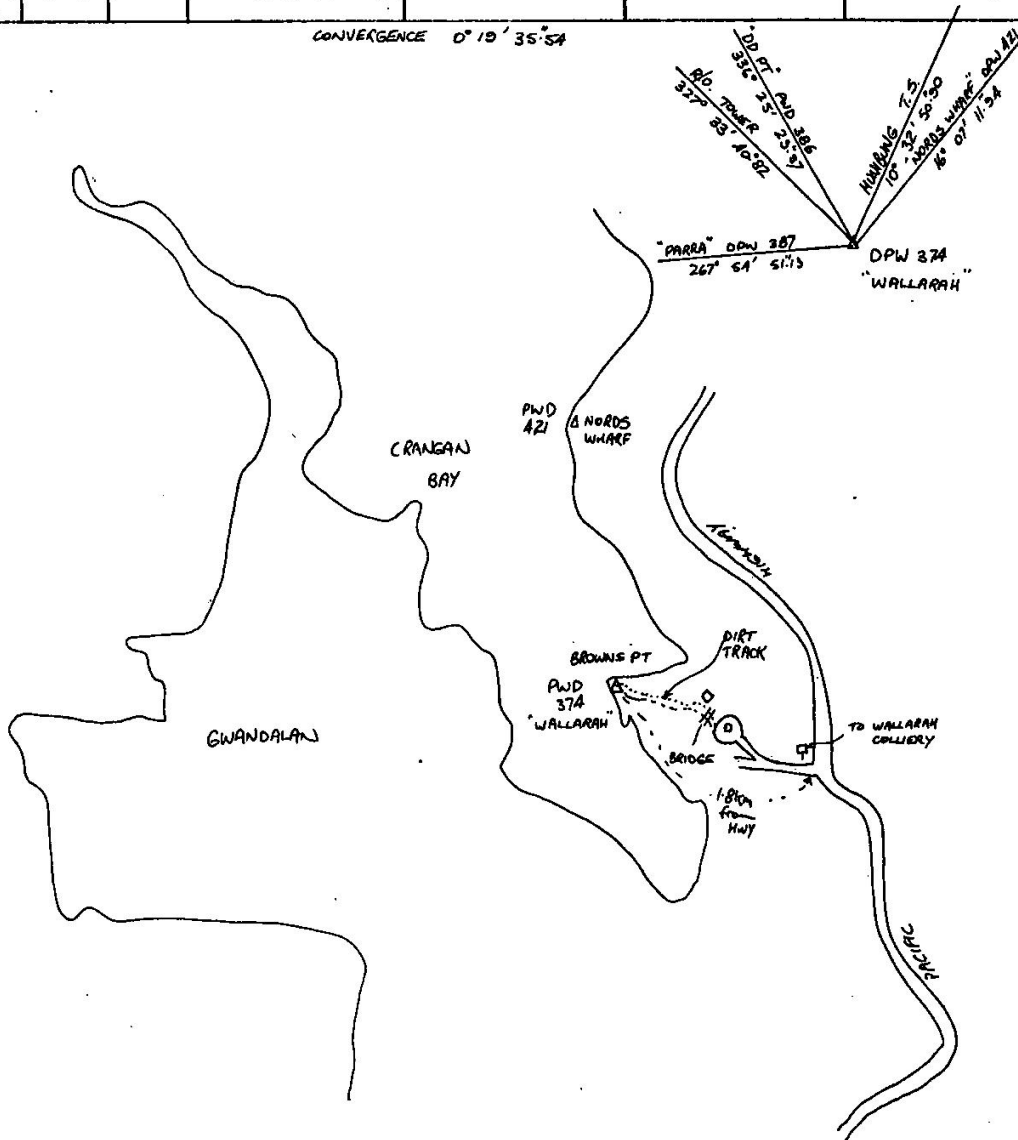

Measurements are in METRES

Placed in connection with LAKE MACQUARIE HYDRO SURVEY

Field Books Level Books

Reduced Level of Mark 9.170 (prov) To Datum A.H.D.

Origin of Levels SSM 4.128 Reduced Level of Origin 78.007 (prov)

Date: 31/3/76 Signature T.H. [Signature]