



P.W.D. SURVEY MARK SKI


TS10059

Parish County City or Town ... FISHING POINT
 Municipality or Shire ... LAKE MACQUARIE

CO-ORDINATES

GRID	ZONE	CM	METRES		YARDS	
			E	N	E	N
AMG						
ISG	56/1		355 933.282	1 340 557.505		
ANG						
LOCAL						

CONVERGENCE 0° 15' 36.32"

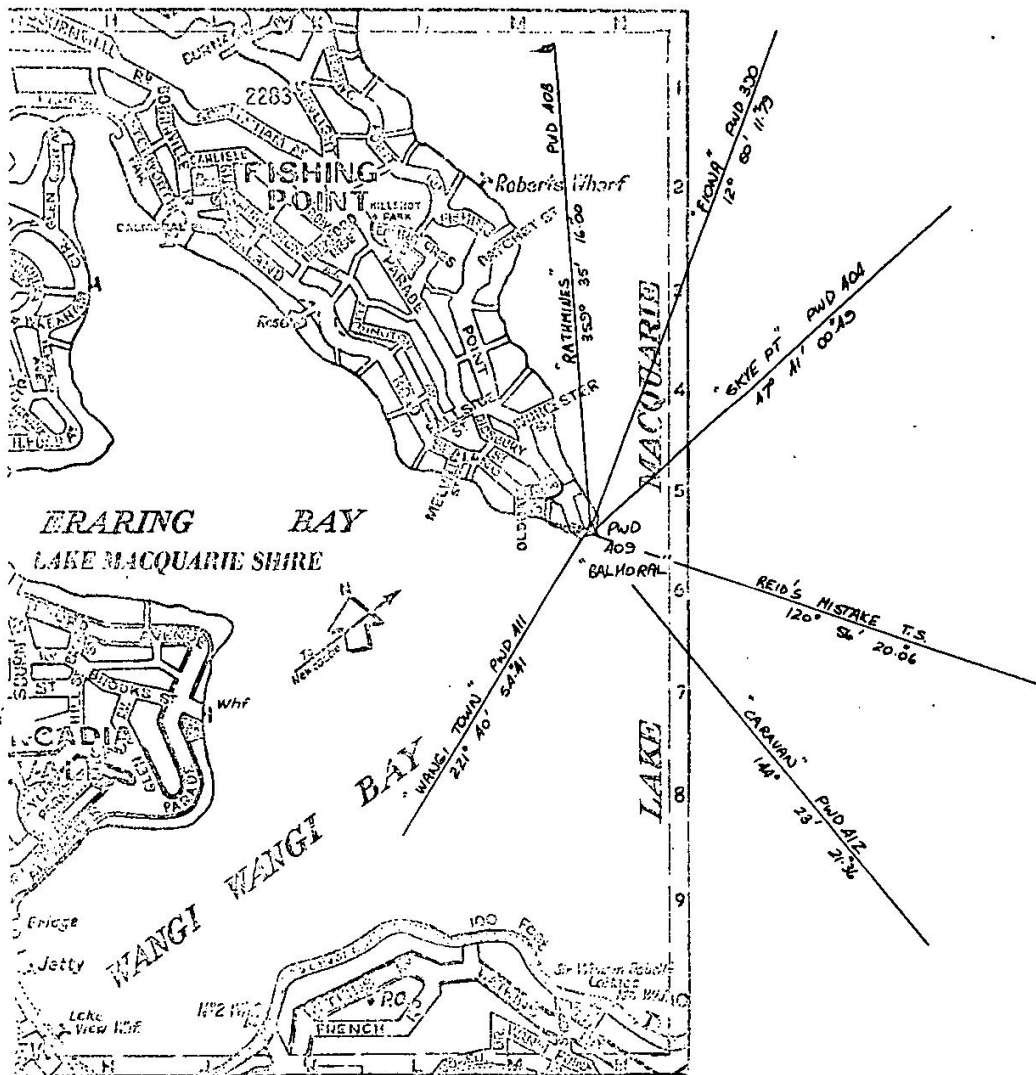

Measurements are in METRES

Placed in connection with LAKE MACQUARIE HYDRO SURVEY

Field Books Level Books

Reduced Level of Mark P.522 (prov.) To Datum A.H.D.

Origin of Levels pm.2557.9 Reduced Level of Origin 9.05.7 (prov)

Date: 31/3/76 Signature T.H. Rogers