


STATION Blues Point / TS 10084

Owners Name.....
 Current Occupant.....
 Address.....
 Address.....

Access
 3-5-1476
 Conventional Vehicle
 UBD MAP 57 Reference O-6
 Access off Blues Pt Rd Blues Pt Nth Sydney
 See caretaker for key to roof. (Caretaker lives on 1st floor).
 Enter lower roof area. and then take steps and ladder to uppermost
 roof area.

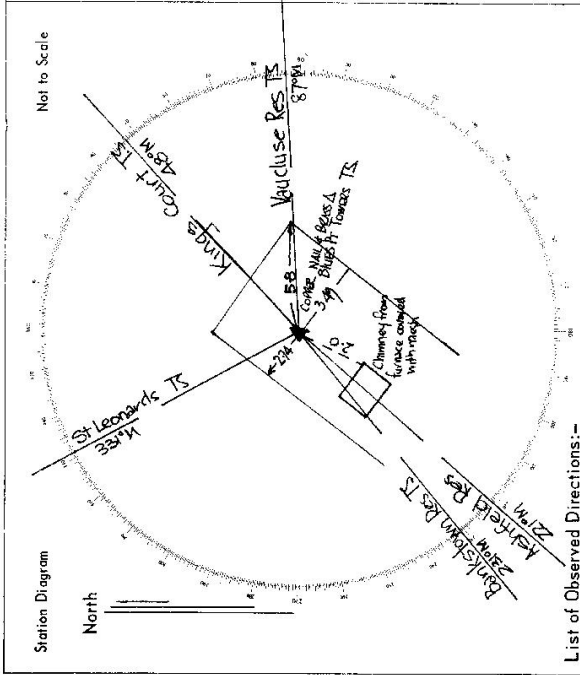

List of Observed Directions:-

Station	Direction	Station	Direction
St Leonards	339° 59' 60"	Kings Court TS	59° 59' 60"
Kings Court TS	17° 20' 20"	Vaucluse Res TS	34° 51' 51.4"
Vaucluse Res TS	114° 20' 11.7"	Ashfield Res TS	165° 51' 51.7"
		Bankstown Res TS	180° 41' 24.7"

Standpoint: Copper nail + brass Δ

Station	Direction	Station	Direction