

CENTRAL MAPPING AUTHORITY

GEODETIC SURVEY OF N.S.W. GEODETIC STATION RECONNAISSANCE and MAINTENANCE REPORT

Description:
 1. Cleared by lanes bearing.....
Note: Cross out word or words which do not apply
 from Trig. Mast

2. Mast & Vanes have been painted white & black respectively.

3. The station/pillar was unpiled/not unpiled/constructed on..... 19..... dimensions now being:

Description of mark..... should be explicit, e.g., S/Steel Pillar Plate, Steel plug, Brass plug, Bolt, G.I. Pipe

Height of mark..... m. ^{above} rock/concrete; Mark is..... m. ^{above} G. L.

Height of Top Vanes to Top Mark/Pillar plate..... m. Diameter of Vanes (vertical)..... m.

Height of Cairn..... m. Diameter of Cairn..... m. Name Plate found/not found/placed.

Length of Mast..... m. (approximate if not unpiled)

4. A..... set in conc./rock has been placed/found, bearing..... °M from Mast/Plug/Pillar

5. A..... set in conc./rock has been placed/found, bearing..... °M from Mast/Plug/Pillar

6. A..... set in conc./rock has been placed/found, bearing..... °M from Mast/Plug/Pillar

7. A..... set in conc./rock has been placed/found, bearing..... °M from Mast/Plug/Pillar

8. Action required:.....

STANDPOINT:

Mark	Direction	Horiz. Distance	Height Difference	Mark	Direction	Horiz. Distance	Height Difference
			above standpt.	blank			above standpt.
			below				below
			above standpt.				above standpt.
			below				below
			above standpt.				above standpt.
			below				below

Prepared by: *[Signature]*

Checked: *[Signature]*

Noted on U.T.M. Card

Sr 2763-1

STATION: *Knights Hill (DWSA) No. 10111*


MAP SHEET
 SCALE 1:250 000

INSPECTED BY: *N.L. Morrison*

DATE: *17-1-79*

AUTHORITY: *C.M.A.*

FIELD BOOK: *1720*

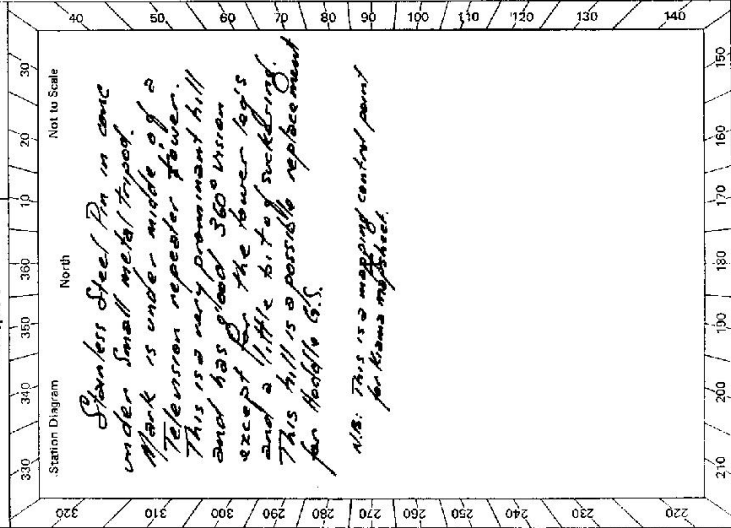

Checked

St 2733-2 D. West, Government Printer Beacon Diagram	TS 10111	STATION KNIGHTS HILL ABWNSA	<table style="width:100%; border-collapse: collapse;"> <tr> <td style="width: 30%;"> Owner's Name: Address: Phone: </td> <td style="width: 30%;"> Current Occupant: Address: Phone: </td> <td style="width: 40%; vertical-align: top;"> ACCESS Access Report of 11.1.1979 was found suitable/unsuitable. Direction 0.00 Robertson P.O. Head towards Wollanford 3.30 Turn right towards Tamboro Plains 6.20 Pass road to Carrington Falls on right 12.90 Turn left Sign Knights Hill 15.60 Knights Hill T.V. Tower </td> </tr> </table>	Owner's Name: Address: Phone:	Current Occupant: Address: Phone:	ACCESS Access Report of 11.1.1979 was found suitable/unsuitable. Direction 0.00 Robertson P.O. Head towards Wollanford 3.30 Turn right towards Tamboro Plains 6.20 Pass road to Carrington Falls on right 12.90 Turn left Sign Knights Hill 15.60 Knights Hill T.V. Tower									
Owner's Name: Address: Phone:	Current Occupant: Address: Phone:	ACCESS Access Report of 11.1.1979 was found suitable/unsuitable. Direction 0.00 Robertson P.O. Head towards Wollanford 3.30 Turn right towards Tamboro Plains 6.20 Pass road to Carrington Falls on right 12.90 Turn left Sign Knights Hill 15.60 Knights Hill T.V. Tower													
Not to Scale			<table style="width:100%; border-collapse: collapse;"> <tr> <td colspan="2"> This section to be completed by officer constructing pillar. </td> </tr> <tr> <td style="width: 50%;"> Original station mark found/not found. </td> <td style="width: 50%;"> Description of mark: </td> </tr> <tr> <td> Original beacon found/not found. </td> <td> Description of beacon: </td> </tr> <tr> <td> Height Top of Vanes to Top Markm. </td> <td> above G.L. below </td> </tr> <tr> <td> Height of markm. above rock/conc.m. below </td> <td> Height of Cairnm. </td> </tr> <tr> <td> Diameter of Vanesm. </td> <td> Original Beacon has/has not been destroyed by me. </td> </tr> </table>	This section to be completed by officer constructing pillar.		Original station mark found/not found.	Description of mark:	Original beacon found/not found.	Description of beacon:	Height Top of Vanes to Top Markm.	above G.L. below	Height of markm. above rock/conc.m. below	Height of Cairnm.	Diameter of Vanesm.	Original Beacon has/has not been destroyed by me.
This section to be completed by officer constructing pillar.															
Original station mark found/not found.	Description of mark:														
Original beacon found/not found.	Description of beacon:														
Height Top of Vanes to Top Markm.	above G.L. below														
Height of markm. above rock/conc.m. below	Height of Cairnm.														
Diameter of Vanesm.	Original Beacon has/has not been destroyed by me.														
			<table style="width:100%; border-collapse: collapse;"> <tr> <td style="width: 50%;">Date</td> <td style="width: 50%;">Record of Station</td> </tr> <tr> <td> </td> <td> </td> </tr> <tr> <td> </td> <td> </td> </tr> <tr> <td> </td> <td> </td> </tr> </table>	Date	Record of Station										
Date	Record of Station														