

# LOCALITY SKETCH PLAN



Local Government Area North Sydney

Town/Suburb/Locality Artarmon


Office Use - Barcode Including Number Inserted Here

Approx MGA Coordinate: Zone .....

Description of Mark Trig Station centre of Tower

E: .....

N: .....

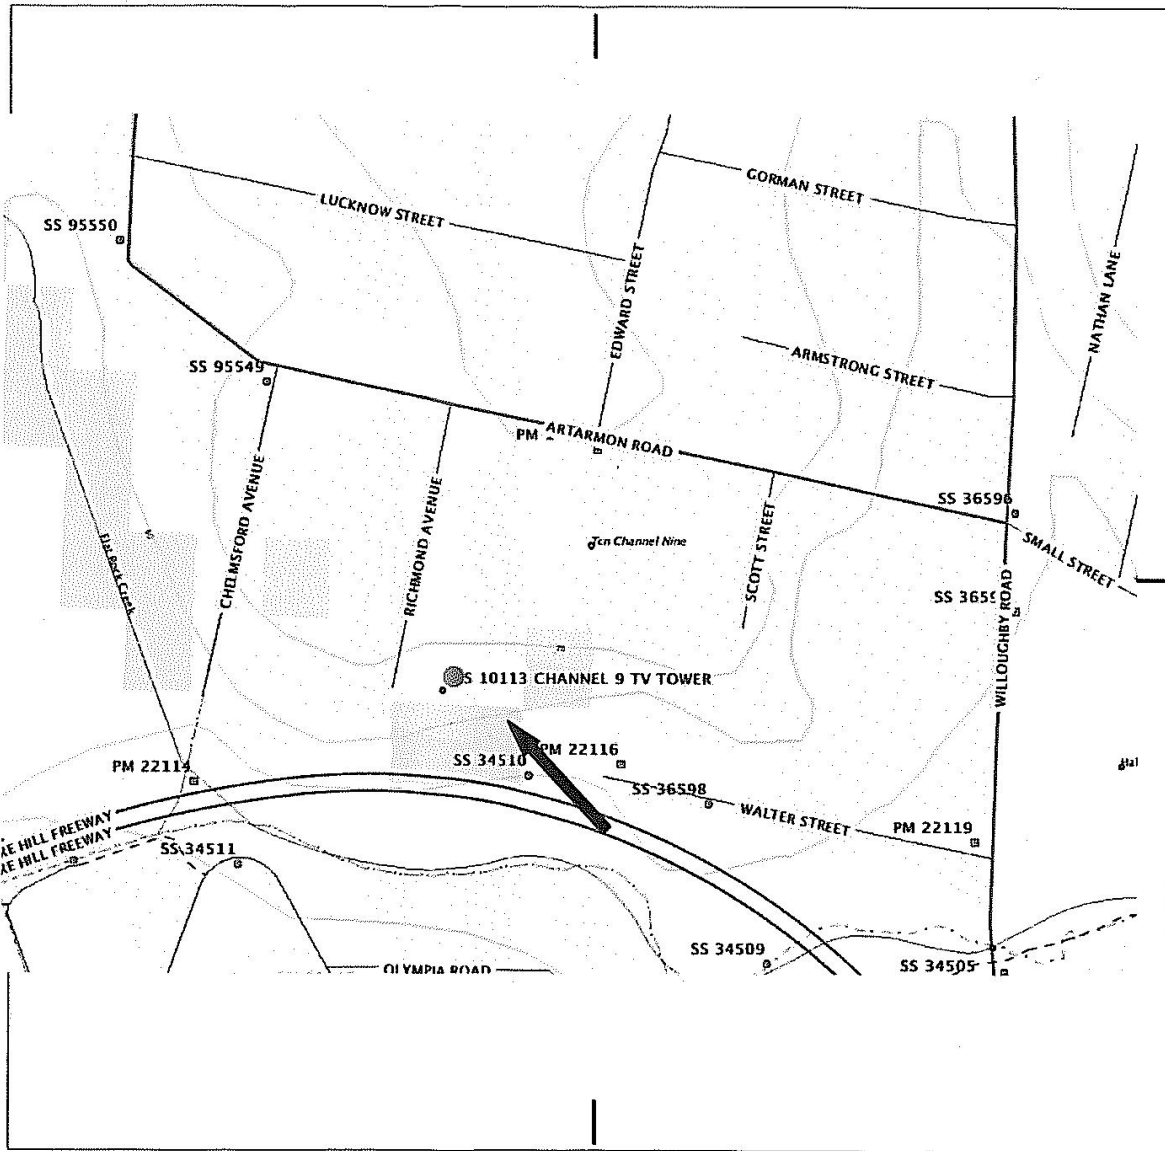

Please use black ink only

SURVEYING REGULATION			
MARK	AHD	SOURCE	DATE
HEIGHT DETERMINED BY		- DIFF. LEVELLING	
(Specify)		- TRIG HEIGHTING	
ADOPTED MARKS		- GPS	

Measurements are in metres

**TS 10113**  
**Channel 9 TV Twr**

PM .....

Replaces SS .....

I certify that the mark has been placed/found and numbered as detailed hereon.

Signed: .....

Name: .....

Organisation placing mark: .....

Date mark placed/found: / /

Ref: .....

# LOCALITY SKETCH PLAN



Local Government Area **Willoughby**  
 Town/Suburb/Locality **Willoughby**

Office Use - Barcode Including Number Inserted Here

Approx MGA Coordinate: Zone .....

Description of Mark .....

E: .....

N: .....

Situated off Artarmon Road between Richmond Ave and Scott Street Willoughby



Please use black ink only

SURVEYING REGULATION			
MARK	AHD	SOURCE	DATE
HEIGHT DETERMINED BY (Specify)		- DIFF. LEVELLING	
		- TRIG HEIGHTING	
ADOPTED MARKS		- GPS	

Measurements are in metres

I certify that the mark has been placed/found and numbered as detailed hereon.

**TS 10113**  
**Channel 9 TV Tower**

Signed: .....

Name: .....

Organisation placing mark: .....

PM .....

Replaces

SS .....

Date mark placed/found: / /

Ref: .....