

STATION T.S. 0122 [SOMERSBY (P)]

Current Occupant: MR. & MRS. DANKS


Address: DEBENHAM RD. SOMERSBY

Owners Name: MR. & MRS. DANKS

Address: DEBENHAM RD. SOMERSBY


Access 20-10-1917

Station Diagram Not to Scale

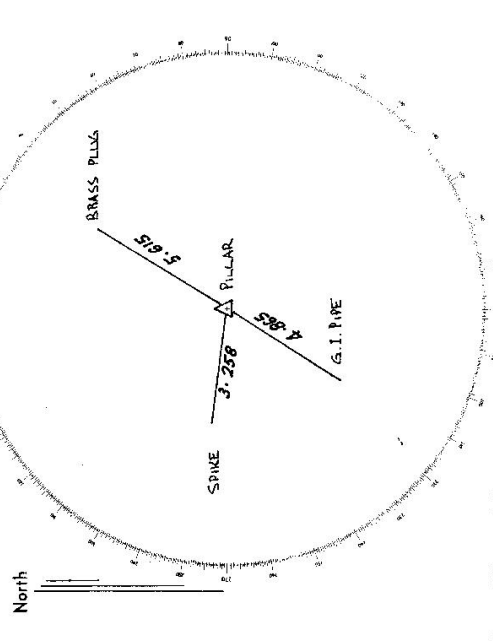

List of Observed Directions:-

Standpoint: PILLAR		Station	
Station	Direction	Station	Direction
ERINA (P)	0° 00' 00"		
SYRE T.S.	116° 29' 20"		
KARIONG T.S.	106° 42' 26.4"		
BRASS PLUG	20° 48' 05"		
G.I.P.	201° 24' 15"		
SPIKE		266° 39' 35"	
Station	Direction	Station	Direction

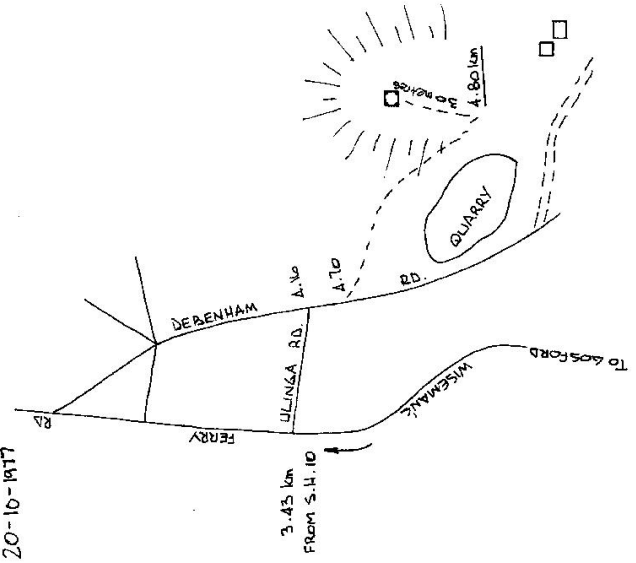


D. West, Government Printer, New South Wales - 1976

STATION **SOMERSBY TS (10177)**


Owners Name.....
 Current Occupant.....
 Address.....
 Address.....

Access 16-3-1919
 2 WD ACCESS

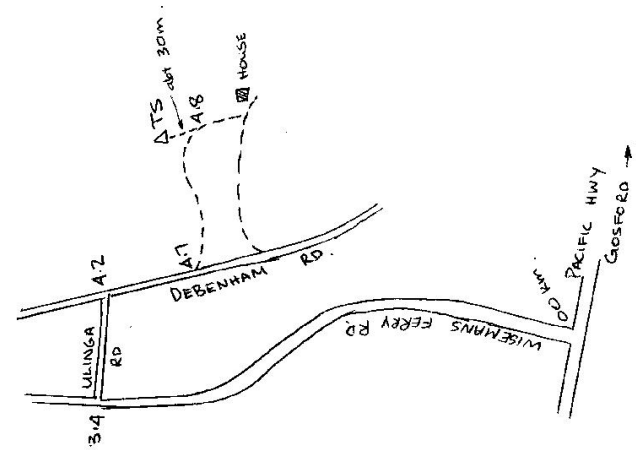

D. West, Government Printer, New South Wales

Not to Scale

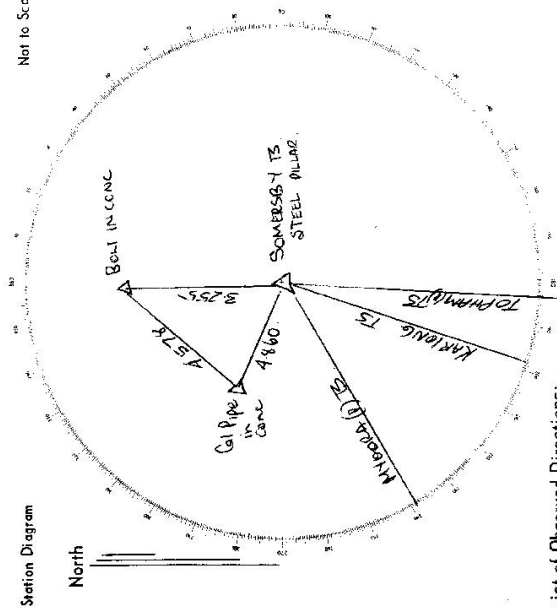

List of Observed Directions:-

Station	Direction	Station	Direction
TORHAWA(TS)	183 24 478	BOLT	0 00 00
KARLONG TS	198 24 282	PILLAR	40 12 59
MIPORA(TS)	238 24 246		
GIP	243 07 473		
BOLT	358 21 387		

Station	Direction	Station	Direction

Standpoint: PILLAR. Standpoint: GIP