




STATION AIRCRAFT TS (DCA HILL) 10124

Owners Name: .....  
 Address: .....  
 Current Occupant: .....  
 Address: .....

Dec 1974  
 CONVENTIONAL VEHICLE

TAKE KNIBBLES ROAD OFF RINEZINA HIGHWAY APPROX 5.8 MILES EAST OF ALBURY.  
 FOLLOW TO LOCKED GATE ON RIGHT AT 2.5 MILES.  
 THROUGH GATE AND FOLLOEY ROAD UP HILL PASSING THROUGH GATE AT 0.6 MILES AND TO GATE 4 TS ON LEFT AT FURTHER 0.15 MILES

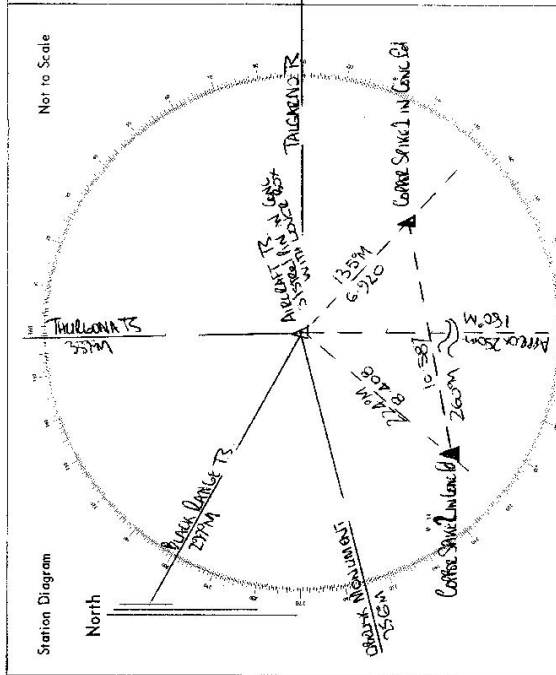

List of Observed Directions:-

Standpoint: Sighting pin

Station	Direction	Station	Direction
THURKONA TS	180°	COPPER SPIKE NO.2	357° 57' 60"
COPPER SPIKE 1	133° 16' 37.5"	STREATHING PIN (AIRCRAFTS)	52° 27' 53"
HOLEY SURVEY RANGES	175° 16' 23.5"		
COPPER SPIKE 2	220° 05' 42.5"		
BLACK RANGE TS	272° 27' 01.5"		

Station	Direction	Station	Direction



