


5-2733-2 D. West, Government Printer

STATION **ROBIN GS 1013**

Owner's Name:
 Address:
 Phone:
 Current Occupant:
 Address:
 Phone:

ACCESS
 Access Report of ~~24/12/1977~~ was found suitable/unstable.

SEE KIRRIKI 1:25000 or 1:31650 map
 Approximately 15 mins walk (no gear) from nearest house.

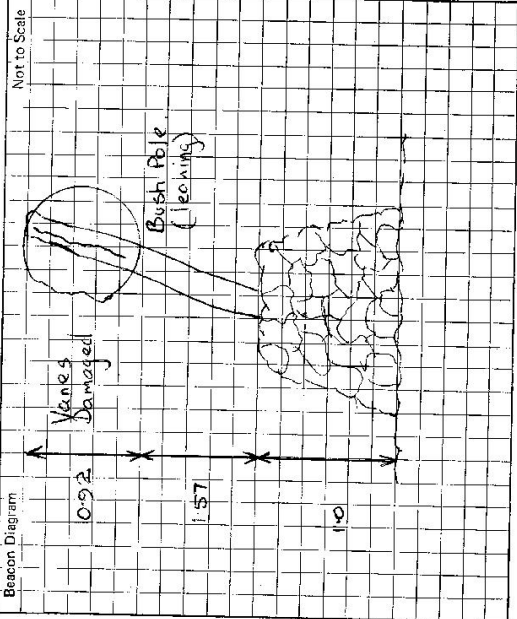

This section to be completed by officer constructing pillar.

Original station mark found/not found.

Description of mark:

Original beacon found/not found.

Description of beacon:

Height Top of Vanes to Top Markft.

Height of markft. above below
 rock/concm. G.L.

Diameter of Vanesm. Height of Cairnm.

Original Beacon has/has not been destroyed by me.

Date	Record of Station