

Department of Lands Integrat Survey of N.S.W.

RECONNAISSANCE and MAINTENANCE REPORT 10133 STATION ILLAWONG (P) TS 10133

This Trig. Station has been:-

1. Completely cleared to permit 360° vision to surrounding Trigs.

2. Cleared by limes bearing..... from Trig. Mast

Note: Cross out word or words which do not apply

Co: _____ Ph: _____

Map Sheet: _____ No: _____

Inspected by: _____ Date: _____

Authority: _____ Field Book: _____

Beacon Diagram _____

Not to Scale

ABSTRACT OF OBSERVATIONS

STATION	To	R.L. (metres)	Direction or Vert. Angle	Variance	Observer	Date	R.L. at M.S.L.	Dist. in metres	Prov. or AL. AND.
				±0.41					
				±1.91					
				±0.60					
				0.74					
				1192.157					PROVISIONAL A-456
				1133					
<p>ELEVATION</p> <p>NOT TO SCALE</p> <p>FO 10133 P 25-78</p> <p>10-72</p>									

All directions Connected to centre

6.39

All Vert's corrected ground to ground

SLE REAR OF CARD FOR REMARKS

14. Diff. Ht. m. above below

15. Diff. Ht. m. above below

16. Diff. Ht. m. above below

Prepared by: _____ Checked: _____

Date _____

Record of Station _____

ILLAWONG (P)

10133 STATION

O

Station Diagram
North
Not to Scale

Owners Name.....
Address.....
Access.....

Current Occupant.....
Address.....

R 270

ILLAWONG RES

Remarks


Key for ladder, until
completeness is completed
from Southern Dist recta.
Inspectors Office,
Bellongarra Rd, Miranda,
TEL: 512 9611 8835
(Ms G. Nevrach)

R 270
RL 92.245

List of Observed Directions:-

Standpoint:		Station:	
Station	Direction	Station	Direction

Standpoint:		Station:	
Station	Direction	Station	Direction

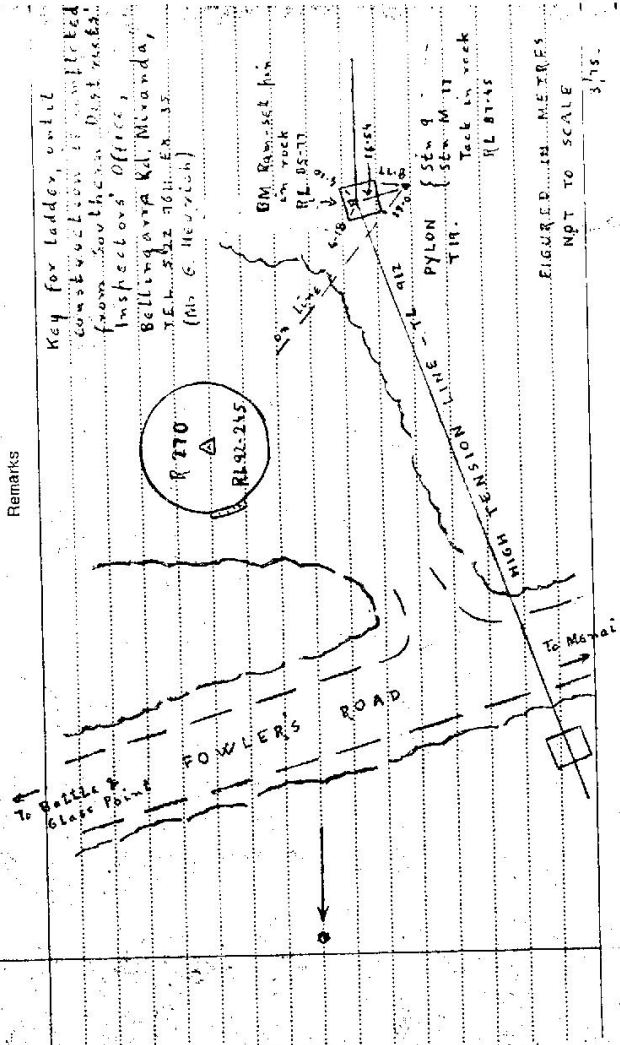

FIGURED IN METRES
NOT TO SCALE
375

D. West, Government Printer, New South Wales - 1976

Department of Lands
 Integration of N.S.W.
 RECONNAISSANCE and MAINTENANCE REPORT
 STATION TS 11-LAWONR (P) 10133
 Co: Ph: No: No: No:
 Map Sheet: Inspected by: J. L. FLETCHEER Date: 16.1.76
 Authority: INTELLIGENCE SURVEYS Field Book: PDF 43112

Beacon Diagram
 Not to Scale
 0.60
 1.32
 0.51
 1.245
 0.17
 School platform

Note: Cross out word or words which do not apply

This Trig. Station has been:-

1. Completely cleared to permit 360° vision to surrounding Trigs.
2. ~~Cleared by James bearing~~..... from Trig. Mast
3. Trig. Mast & Vanes have been painted white & ~~black respectively~~.
4. The Trig. was unpiled/not unpiled, dimensions now being:
 - Description of mark: Steel pillar should be explicit, e.g. Steel plug, Brass plug, Bolt, Concrete Pillar
 - Height of mark: 0.60 m ^{above} rock/concrete 0.51 m ^{below} G.L.
 - Height of Top Vanes to Top Mark/Top pillar plate: 2.41 m Diameter of Vanes (vertical): 0.60 m.
 - Height of Cairn: 0.17 m. Diameter of Cairn: 0.17 m.
5. ~~A~~..... set in conc/rock has been placed/fd m. bearing.....°M. from Trig. Mast/pillar
6. ~~A~~..... set in conc/soil has been placed/fd m. bearing.....°M. from Trig. Mast/pillar
7. ~~A~~..... set in conc/soil has been placed/fd m. bearing.....°M. from Trig. Mast/pillar
8. ~~A~~..... set in conc/rock has been placed/fd m. bearing.....°M. from Trig. Mast/pillar
9. Connection..... to..... m. bearing.....°M
10. Connection..... to..... m. bearing.....°M
11. Connection..... to..... m. bearing.....°M
12. Connection..... to..... m. bearing.....°M
13. Diff. Ht. is..... m. ^{above} below
14. Diff. Ht. is..... m. ^{above} below
15. Diff. Ht. is..... m. ^{above} below
16. Diff. Ht. is..... m. ^{above} below

Prepared by: J. Fletcher Checked: [Signature]

Date: Record of Station



10133 STATION TS ILL. JONG (P) 10133

Owners Name... M.W.S. & P.B. Current Occupant.....

Address..... Address.....

Access 16-1-1976

U.B.D. MAP 97 M4
TENTH EDITION
WATER BOARD KEY
REQUIRED FOR ACCESS
TO RESERVOIR.

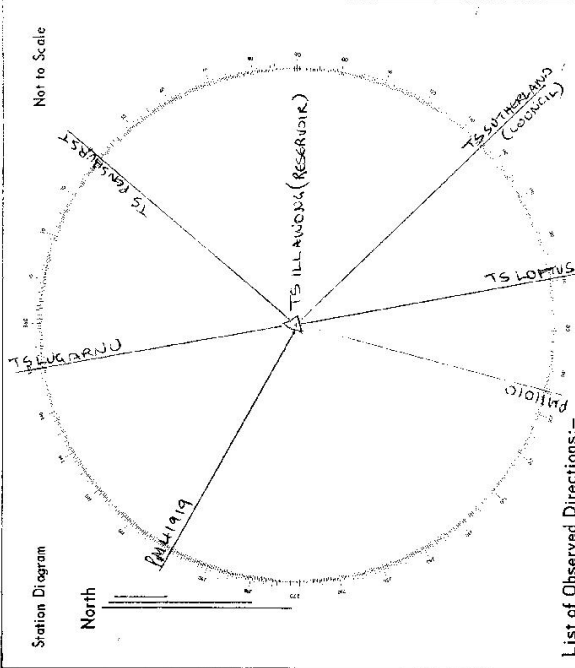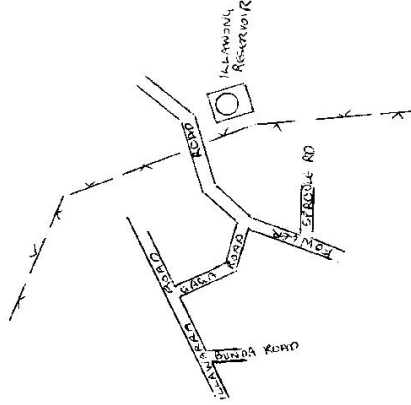

List of Observed Directions:-

Stationpoint: TS ILLAWONG		Stationpoint: TS ILLAWONG (CONT'D)	
Station	Direction	Station	Direction
TS PENSURS	0° 00' 00"	PHILIC	246° 53' 05"
TS SWITHRANK (COUNCIL)	97° 44' 47"	TS LOTTUS	117° 02' 23"
TS LOTTUS	130° 41' 55"		
TS LUGARNO	309° 48' 49"		
PHILIC	154° 10' 28"		

Station	Direction	Station	Direction