

Department of Lands

Integration of N.S.W. RECONNAISSANCE and MAINTENANCE REPORT (C/24) STATION TS SUTHERLAND LOCAL 10134

This Trig. Station has been:-

Note: Cross out word or words which do not apply

1. Completely cleared to permit 360° vision to surrounding Trigs.
2. Cleared by lanes bearing..... from Trig. Mast
3. Trig. Mast & Vanes have been painted white & black respectively.

4. The Trig. was unpainted/unpainted, dimensions now being:

Description of mark: ~~Painted~~ ~~White~~ ~~Black~~ ~~Dimensions~~ ~~now~~ being: ~~.....~~ from Trig. Mast

Height of mark: ~~.....~~ m ^{above} ~~below~~ rock/concrete ~~.....~~ m ^{above} ~~below~~ G.L.

Height of Top Vanes to Top Mark/Top pillar plate: ~~.....~~ m Diameter of Vanes (vertical): ~~.....~~ m.

Height of Cairn: ~~.....~~ m. Diameter of Cairn: ~~.....~~ m.

Length of Mast: ~~.....~~ m. (approximate if not unpainted)

5. A. ~~.....~~ set in conc/rock has been placed/rd ~~.....~~ m. bearing ~~.....~~ °M from Trig. Mast/pillar

6. A. ~~.....~~ set in conc/soil has been placed/rd ~~.....~~ m. bearing ~~.....~~ °M from Trig. Mast/pillar

7. A. ~~.....~~ set in conc/soil has been placed/rd ~~.....~~ m. bearing ~~.....~~ °M from Trig. Mast/pillar

8. A. ~~.....~~ set in conc/rock has been placed/rd ~~.....~~ m. bearing ~~.....~~ °M from Trig. Mast/pillar

9. Connection: ~~.....~~ to ~~.....~~ m. bearing ~~.....~~ °M

10. Connection: ~~.....~~ to ~~.....~~ m. bearing ~~.....~~ °M

11. Connection: ~~.....~~ to ~~.....~~ m. bearing ~~.....~~ °M

12. Connection: ~~.....~~ to ~~.....~~ m. bearing ~~.....~~ °M

13. Diff. Ht. ~~.....~~ is ~~.....~~ m. ^{above} ~~below~~ ~~.....~~ m. ^{above} ~~below~~ ~~.....~~ m.

14. Diff. Ht. ~~.....~~ is ~~.....~~ m. ^{above} ~~below~~ ~~.....~~ m. ^{above} ~~below~~ ~~.....~~ m.

15. Diff. Ht. ~~.....~~ is ~~.....~~ m. ^{above} ~~below~~ ~~.....~~ m. ^{above} ~~below~~ ~~.....~~ m.

16. Diff. Ht. ~~.....~~ is ~~.....~~ m. ^{above} ~~below~~ ~~.....~~ m. ^{above} ~~below~~ ~~.....~~ m.

Prepared by: M. Fletcher

Checked: C.S. [Signature]

Co: _____ Ph: _____ No: _____


Map Sheet: _____

Prepared by: J.L. Fletcher Date: OCT. 1975

Authority: INTERSECTION SURVEYS Field Book: _____

Section Diagram

Not to Scale

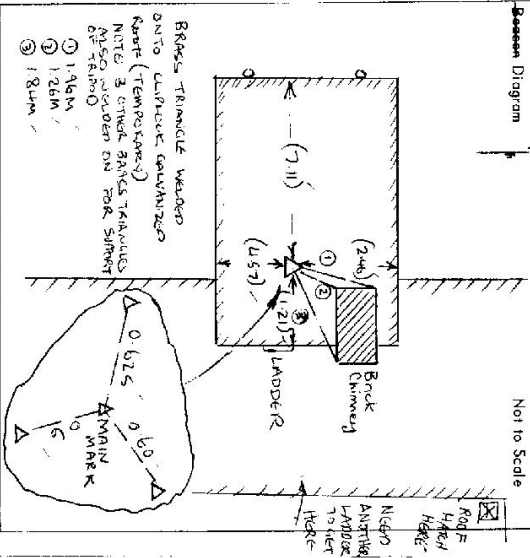

Record of Station

Date


STATION TS SUTHERLAND COUNCIL IS 10134

Owners Name... SUTHERLAND COUNCIL Current Occupant.....

Address... Cnr. ETON ST. AND SAUNDERS HIGHWAY. Address.....

SUTHERLAND

Access Oct 1975
 SEE SUPERVISOR OF THE BUILDING.
 WILL NEED TWO LADDERS ONE TO GET TO THE ROOF HATCH
 AND THE OTHER TO GET TO THE TOP ROOF.

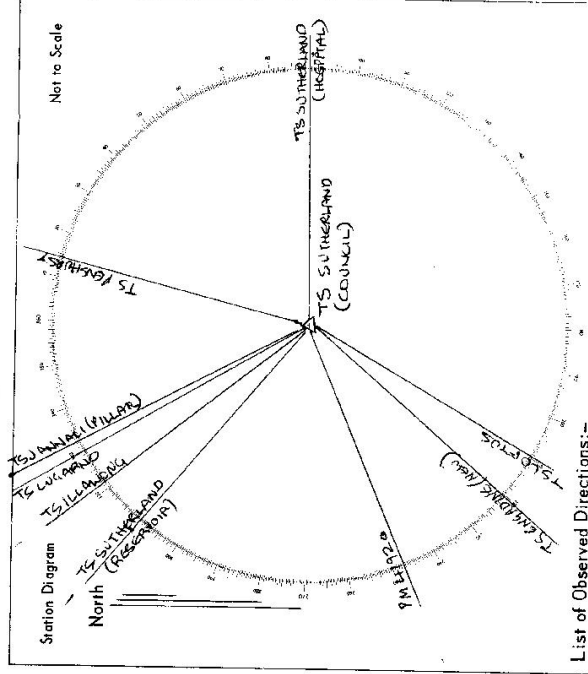

List of Observed Directions:-

Standpoint: TS SUTHERLAND (COUNCIL) Standpoint:

Station	Direction	Station	Direction
TS LILARNIO	0 00 00	TS LILARNIO (RES)	102 31 32.6
TS PENSHURST	27 57 48.6	TS JANNAH (PILLAR)	112 28 49.9
TS SUTHERLAND (HOSPITAL)	110 24 46		
TS LILARNIO (RESERVATION)	349 33 33.2		
TS LILARNIO (RESERV)	89 04 18.4		

Station	Direction	Station	Direction
TS LILARNIO	0 00 00		
TS PENSHURST	44 12 32.7		
TS SUTHERLAND (HOSPITAL)	119 00 07.8		