

Department of Lands

This Trig. Station has been

1. Completely cleared
2. Cleared by lines be
3. Trig. Mast & Vane
4. The Trig. was unpi

Description of mark

Height of mark.....

Height of Top Vane.....

Height of Cairn.....

Length of Mast.....

5. A.....set in

6. A.....set in

7. A.....set in

8. A.....set in

9. Connection.....

10. Connection.....

11. Connection.....

12. Connection.....

13. Diff. Ht.

14. Diff. Ht.

15. Diff. Ht.

16. Diff. Ht.

Prepared by:

Checked:

Integration Key of N.S.W.

RECONNAISSANCE and MAINTENANCE REPORT 10137

STATION DURAL STH TS 10137

Ph:


No:

Date:

Field Book:

Not to Scale

Location diagram for
Dural South Reservoir

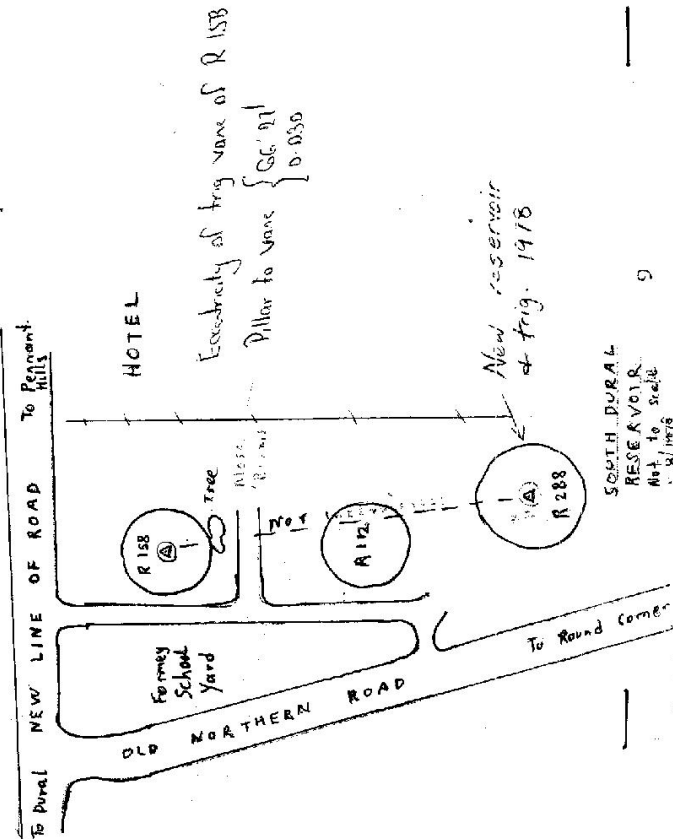

Record of Station