




STATION College T.S 10145

Owners Name: EDUCATION DEPT. Current Occupant: .....

Address: ..... Address: .....

22-4-1976  
 Access Conventional Vehicle  
 Trig is situated in Tower of King's College of Advanced Education: Make Yourself known to House Officer Room 566  
 Note Key to locked door is obtained from House Officer  
 Main entrance off Eton Rd Room 566

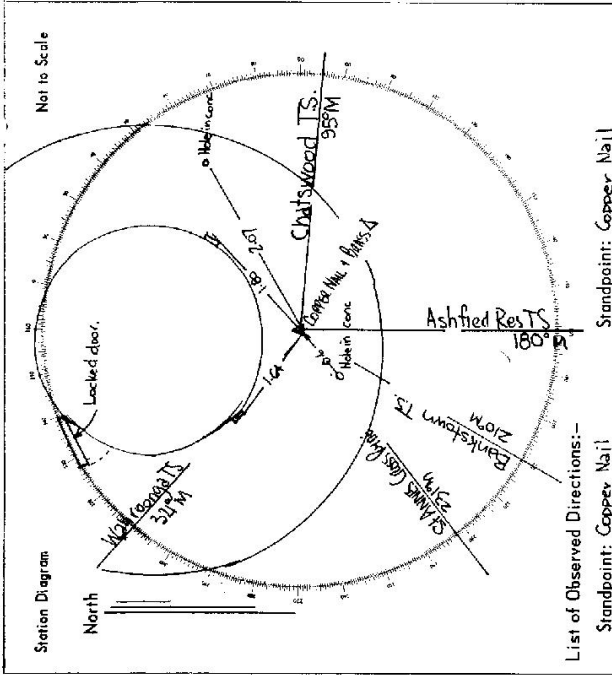

List of Observed Directions:-

Standpoint: Copper Nail		Standpoint: Copper Nail	
Station	Direction	Station	Direction
Chatswood TS	357° 59' 60"	Chatswood TS	287° 59' 60"
Church Spire Bymble	119° 37' 18"	Ashfield TS	45° 00' 02"
Elgin Lodge	191° 55' 22"	Bankstown TS	110° 48' 12"
		St Annes Cross	130° 12' 40"
		Beadam TS	169° 11' 50"
		Wilmington Mast TS	221° 13' 09"
Station	Direction	Station	Direction