


Department of Lands Integration any of N, S, W  
**RECONNAISSANCE and MAINTENANCE REPORT 10150 STATION**  
**TAREEN (P) 10150**

Co: **ROXBURGH** Ph: **KELSO**  
 Map Sheet: **1118**  
 Inspected by: **M.A. MATKINS** No: **Nov 75**  
 Authority: **ORANGE LBS.** Field Book No: **668**  
 Not to Scale

Beacon Diagram

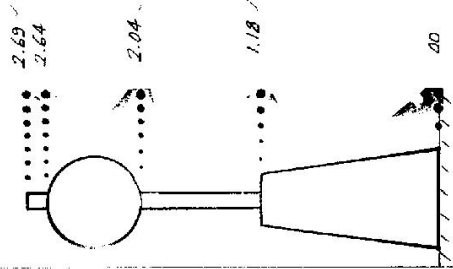

Date: **27 75** Record of Station  
**PILLAR ERECTED**

Note: Cross out word or words which do not apply

This Trig. Station has been:-

1. Completely cleared to permit 360° vision to surrounding Trigs.
2. Cleared by ~~lanes bearing~~ **from Trig-Mast**
3. Trig. Mast & Vanes have been painted white & black respectively.
4. The Trig. was ~~erected~~ **not** unpiled, dimensions now being:

Description of mark: **CONCRETE PILLAR** should be explicit, e.g. Steel plug, Brass plug, Bell, Concrete Pillar  
 Height of mark: **1.18** m above **rock/concrete** **1.18** m above **G.L.**  
 Height of Top Vanes to Top Mark/Top pillar plate: **1.46** m Diameter of Vanes (vertical) **0.60** m.  
 Height of **Cap** m. Diameter of **Cap** m.  
 Length of Mast **1.51** m. (approximate if not unpiled)

5. A **GP** set in conc/rock has been placed **4.280** m, bearing **278** <sup>°</sup> **01** <sup>'</sup> **00** <sup>"</sup> from Trig. **Mast**/pillar
6. A **GS** set in conc/soil has been placed **4.340** m, bearing **354** <sup>°</sup> **04** <sup>'</sup> **00** <sup>"</sup> from Trig. **Mast**-pillar
7. A set in conc/soil has been placed **4.00** m, bearing **000** <sup>°</sup> **00** <sup>'</sup> **00** <sup>"</sup> from Trig. **Mast**-pillar
8. A set in conc/rock has been placed **4.00** m, bearing **000** <sup>°</sup> **00** <sup>'</sup> **00** <sup>"</sup> from Trig. **Mast**/pillar

9. Connection **GS** to **GP** : **3.534** m, bearing **235** <sup>°</sup> **05** <sup>'</sup> **00** <sup>"</sup>
10. Connection to : m, bearing **000** <sup>°</sup> **00** <sup>'</sup> **00** <sup>"</sup>
11. Connection to : m, bearing **000** <sup>°</sup> **00** <sup>'</sup> **00** <sup>"</sup>
12. Connection to : m, bearing **000** <sup>°</sup> **00** <sup>'</sup> **00** <sup>"</sup>
13. Diff. Ht. **GP** is **1.328** m above **PILLAR PLATE** below
14. Diff. Ht. **GS** is **1.295** m above **PILLAR PLATE** below
15. Diff. Ht. is m above below
16. Diff. Ht. is m above below

Prepared by: **[Signature]** Checked: **[Signature]**

STATION **TAREEN (P) 10150**

Owners Name: **L.C. PASTORAL Co. Pty. Ltd.**

Current Occupant:



Address: **% PERPETUAL TRUSTEE Co. LTD.**

Address

**MUNTER ST. SYDNEY.**

**Nov 1975**

ACCESS  
 00 KEESLO RD. TAKE DARBON ROAD  
 0.4 RAILWAY CROSSING  
 1.1 ROAD JUNCTION KEEP ON DARBON ROAD  
 1.5 SCOTT'S SCHOOL ON RIGHT. TURN RIGHT THRU GATE & TAKE  
 4.5 MAIN DR. "TAREEN" ON RIGHT. TURN RIGHT THRU GATE & TAKE  
 TRAIL PAST HOUSE & SANDS TO T3.

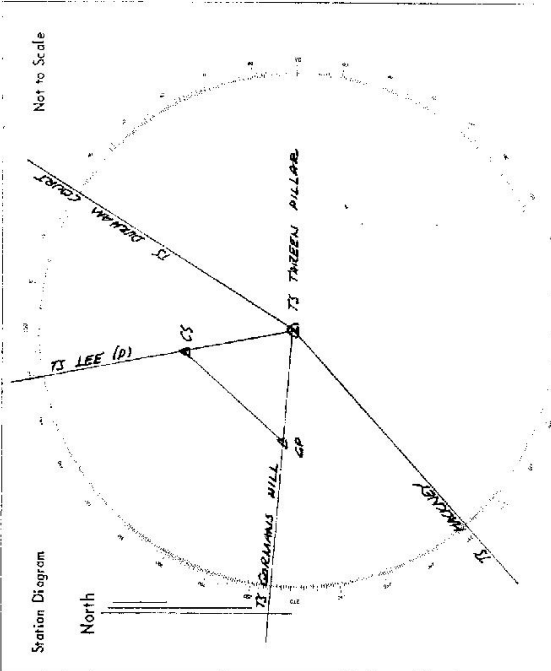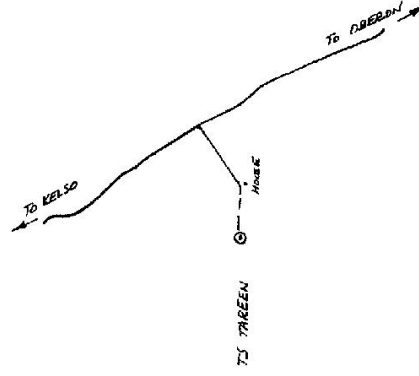

List of Observed Directions:-

Standpoint:		PILLAR	
Station	Direction	Station	Direction
		HACKNEY T3	109 59 66
		GP	46 02 36
		CS	121 53 08.2
Standpoint: CS		Standpoint: CS	
Station	Direction	Station	Direction
		LEE T3 (P)	109 59 66
		TAREEN T3 (P)	86 00 00
		GP	329 00 48



