


75 012

STATION 10192 **GURMANS HILL (P)**

Co: **BATHURST** Ph: **BATHURST** No:  
 Inspected by: **M. A. WATKINS** Date: **Nov 75**  
 Authority: **ORANGE LBO** Field Book: **PM 628**

Map Sheet: \_\_\_\_\_  
 Not to Scale

Beacon Diagram

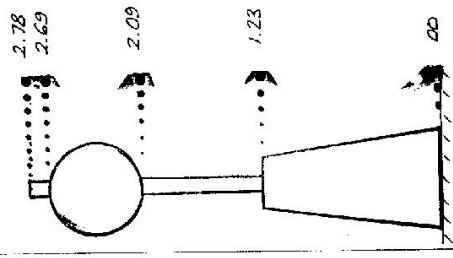

Date	Record of Station
07 75	Pillar erected.

Department of Lands  
 Integration of N.S.W.  
 RECONNAISSANCE and MAINTENANCE REPORT

Note: Cross out words or words which do not apply

This Trig. Station has been:

1. Completely cleared to permit 360° vision to surrounding Trigs.
2. Cleared by fenes bearing **from Trig. Mast**
3. Trig. Mast & Vanes have been painted white & black respectively.
4. The Trig. was ~~erected~~/not unplied, dimensions now being:

Description of mark: **CONCRETE PILLAR** should be explicit, e.g. Steel plug, Brass plug, Bolt, Concrete Pillar  
 Height of mark: **1.23** m <sup>above</sup> ~~below~~ rock concrete **1.23** m above G.L.

Height of Top Vanes to Top Mark/Top pillar plate: **1.46** m Diameter of Vanes (vertical): **0.60** m.

Height of Centre: \_\_\_\_\_ m. Diameter of Centre: \_\_\_\_\_ m.

Length of Mast: **1.55** m. (approximate if not unplied)

5. A **GP** set in conc/rock has been placed **44.3.057** m. bearing **170.19** from Trig. Mast/pillar
6. A **CS** set in conc/soil has been placed **44.3.087** m. bearing **48.5** from Trig. Mast/pillar
7. A \_\_\_\_\_ set in conc/soil has been placed **fd** m. bearing \_\_\_\_\_ from Trig. Mast/pillar
8. A \_\_\_\_\_ set in conc/rock has been placed **fd** m. bearing \_\_\_\_\_ from Trig. Mast/pillar

9. Connection **GP** to **CS** **5.219** m. bearing **22.8** M

10. Connection \_\_\_\_\_ to \_\_\_\_\_ m. bearing \_\_\_\_\_ M

11. Connection \_\_\_\_\_ to \_\_\_\_\_ m. bearing \_\_\_\_\_ M

12. Connection \_\_\_\_\_ to \_\_\_\_\_ m. bearing \_\_\_\_\_ M

13. Diff. Ht. **GP** is **1.45** m. <sup>above</sup> ~~below~~ **PILLAR PLATE**

14. Diff. Ht. **CS** is **1.37** m. <sup>above</sup> ~~below~~ **PILLAR PLATE**

15. Diff. Ht. \_\_\_\_\_ is \_\_\_\_\_ m. <sup>above</sup> ~~below~~

16. Diff. Ht. \_\_\_\_\_ is \_\_\_\_\_ m. <sup>above</sup> ~~below~~

Prepared by: \_\_\_\_\_ Checked: **[Signature]**

TS  
STATION 10152  
GORMANS HILL (P)



Owners Name: ESTATE: A.S. McPHILLAMY  
Current Occupant

Address: GORMANS HILL ROAD  
Address

BATHURST

Nov 1975

Access  
 TO CUR RUSSELL AND HINDHAM ST. BATHURST  
 GO UNDER RAILWAY ALONG GORMANS HILL ROAD  
 O.S. BRIDGE  
 1.8 GATE ON LEFT. TRAIL VISIBLE ALONG FENCE.

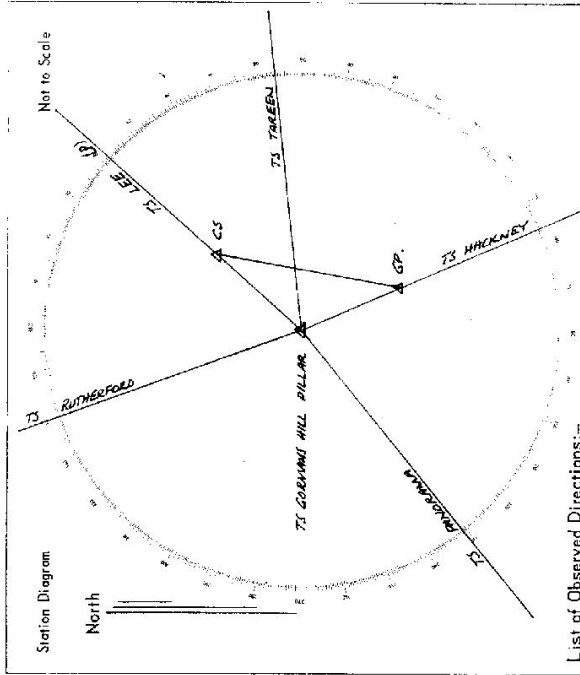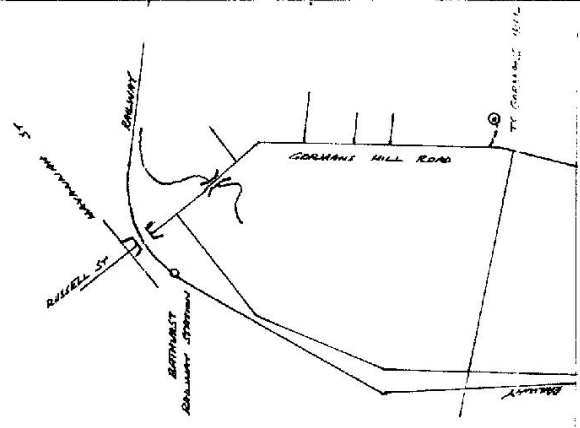

List of Observed Directions:-

Standpoint:		PILLAR	
Station	Direction	Station	Direction
		PANDORRA TS	159 59 60
		CS	170 29 28.9
		GP	286 52 41
Standpoint:		GP	
Station	Direction	Station	Direction
		HACKNEY TS	159 59 60
		GORMANS HILL TS (P)	186 49 40
		CS	211 53 42

CENTRAL MAPPING AUTHORITY

GEODETIC STATION RECONNAISSANCE and MAINTENANCE REPORT

Description:

- Note: Cross out word or words which do not apply*
1. Cleared by lanes bearing... **All round except for house to South from Trig. Mast**
  2. Mast & Vanes have been painted white & black respectively.
  3. The station/pillar was unpiled/not unpiled/constructed on..... 19....., dimensions now being:  
Description of mark..... should be explicit, e.g., S/Steel Pillar Plate, Steel plug, Brass plug, Bolt, G.I. Pipe  
Height of mark..... m. <sup>above</sup>/<sub>below</sub> rock/concrete; Mark is..... m. <sup>above</sup>/<sub>below</sub> G.L.  
Height of Top Vanes to Top Mark/Pillar plate..... m. Diameter of Vanes (vertical)..... m.  
Height of Cairn..... m. Diameter of Cairn..... m. Name Plate found/not found/placed.  
Length of Mast..... m. (approximate if not unpiled)
  4. A..... set in conc./rock has been placed/found, bearing..... °M from Mast/Plug/Pillar
  5. A..... set in conc./rock has been placed/found, bearing..... °M from Mast/Plug/Pillar
  6. A..... set in conc./rock has been placed/found, bearing..... °M from Mast/Plug/Pillar
  7. A..... set in conc./rock has been placed/found, bearing..... °M from Mast/Plug/Pillar
  8. Action required.....

STANDPOINT:

Mark	Direction	Horiz. Distance	Height Difference	Mark	Direction	Horiz. Distance	Height Difference
			above standpt				above standpt
			below standpt				below standpt
			above standpt				above standpt
			below standpt				below standpt
Prepared by: *[Signature]* 9/12/19

Checked: *[Signature]* Noted on U.T.M. Carta


STATION: **GORMANS HILL** TS No.: **10152**  
 MAP SHEETS SCALE 1:250 000 **BATHURST** SCALE 1:100 000  
 INSPECTED BY: **J. Sherwin** DATE: **5/2/19**  
 AUTHORITY: **CMA** FIELD BOOK: **/**

Station Diagram  
North  
Not to Scale

GORMANS HILL TS 10152

05/2733-2 D. WALKS GOVERNMENT PRINTS

STATION

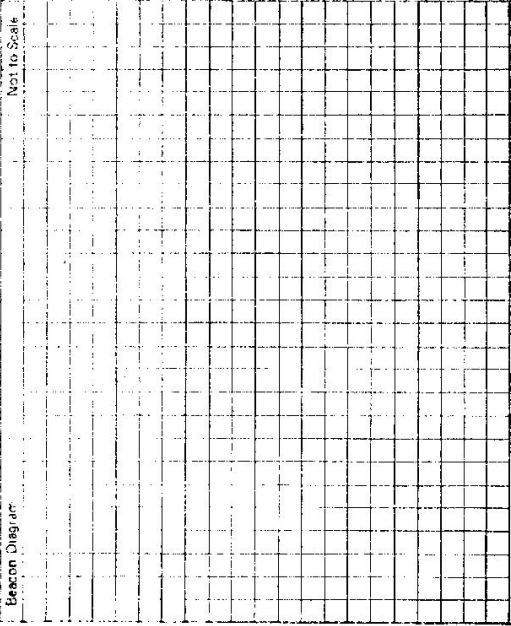

Owner's Name: **PETER McPHILLAMY**

Address:

Phone: **067 311 600**

Current Occupant:

Address:

Phone:

ACCESS

Access Report of: **NA** has found suitable/unsuitable.

0.0 Car Russell & Havanah Sts Boshurst - Go under Railway Along Gormans Hill Rd.

082 Bridge

2.06 Enter Gate on left

2.20 Owners House (unable to contact) Trig outside fenced yard - drive to. (Imperial Allen key bolts)

ALTERNATE ACCESS

- 0.0 In front of C.M.A. HEAD TOWARDS Mt PANORAMA -
- 1.04 Turn left into Havanah St. ;
- 1.15 Turn Right into Lloyd St.; 168 Cross College Rd
- 2.48 Cross main Rail line (Level Crossing)
- 2.55 Cross main Road at Cattle Saleyards
- 3.29 Palmers Bridge
- 3.66 Turn left at intersection
- 3.80 Turn Right through gate & up hill to Visible Pillar.

Record of Station

Date

This section to be completed by officer constructing pillar.

Original station mark found/not found.

Description of mark:

Original beacon found/not found.

Description of beacon:

Height Top of Vanes to Top Mark.....m.

Height of mark.....m. above G.L. below

Diameter of Vanes.....m.

Original Beacon has/has not been destroyed by ma. Height of Cairn.....m.