


Department of Lands
 STATION AVONDALE 10154

Co: ROXBURGH Ph: JEDBURGH
 Map Sheet: No:
 Inspected by: W. A. WATKINS Date: Nov 1975
 Authority: ORANGE LEO Field Book: 668

Beacon Diagram Not to Scale

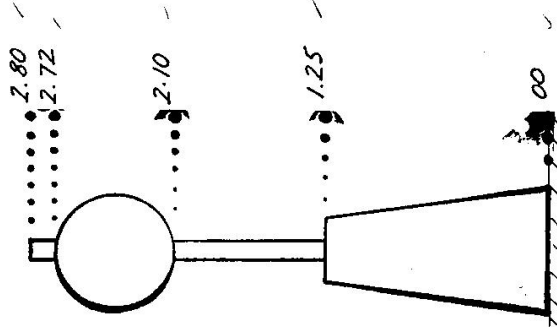

Date	Record of Station
<u>Oct 75</u>	<u>PILLAR ERECTED</u>

RECONNAISSANCE and MAINTENANCE REPORT 10154

This Trig. Station has been:- Note: Cross out word or words which do not apply

1. Completely cleared to permit 360° vision to surrounding Trigs.
2. ~~Cleared by~~ lanes-bearing ~~from Trig.~~ Mast
3. Trig. Mast & Vanes have been painted white & black respectively.
4. The Trig. was ~~emptied~~/not unpiled, dimensions now being:

Description of mark CONCRETE PILLAR should be explicit, e.g. Steel plug, Brass plug, Bolt, Concrete Pillar
 Height of mark 1.25 m ^{above} ~~below~~ rock/concrete 1.25 m ^{above} ~~below~~ G.L.
 Height of Top Vanes to ~~Top Mast~~ Top pillar plate 1.47 m Diameter of Vanes (vertical) 0.62 m.
 Height of ~~Centre~~ Centre m. Diameter of ~~Centre~~ Centre m.

- Length of Mast 1.55 m. (approximate if not unpiled)
5. A GP set in conc/~~rock~~ has been placed/~~fd~~ 3.29 m. bearing 118 ✓ °M from Trig. ~~Mast~~/pillar
 6. A CS set in conc/~~soil~~ has been placed/~~fd~~ 2.78 m. bearing 215 ✓ °M from Trig. ~~Mast~~/pillar
 7. A set in conc/~~soil~~ has been placed/~~fd~~ m. bearing °M from Trig. ~~Mast~~/pillar
 8. A set in conc/~~rock~~ has been placed/~~fd~~ m. bearing °M from Trig. ~~Mast~~/pillar


9. Connection GP to CS : 4.359 m. bearing 250 °M
10. Connection to : m. bearing °M
11. Connection to : m. bearing °M
12. Connection to : m. bearing °M
13. Diff. Ht. GP is 1.53 m. ^{above} ~~below~~ PILLAR PLATE ✓
14. Diff. Ht. CS is 1.515 m. ^{above} ~~below~~ PILLAR PLATE ✓
15. Diff. Ht. is m. ^{above} ~~below~~
16. Diff. Ht. is m. ^{above} ~~below~~

Prepared by: W. A. Watkins Checked:

STATION 10154 AVONDALE (P)

Owners Name: COX C.B.
 Current Occupant:
 Address: AVONDALE
 EGLINGTON

Access Nov 1975

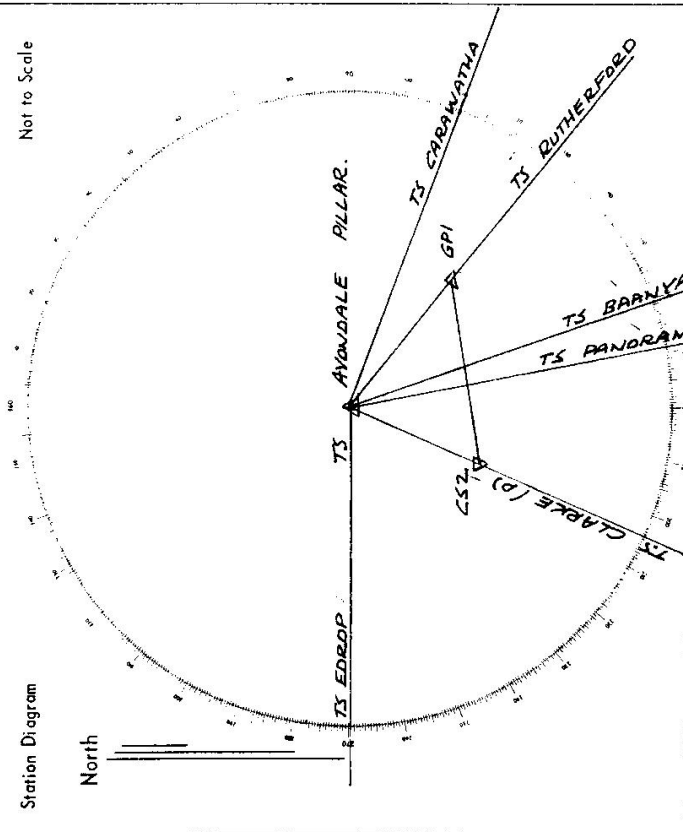

List of Observed Directions:-

Standpoint: PILLAR		Standpoint: GPI	
Station	Direction	Station	Direction
EDROP TS	359 59 60	RUTHERFORD TS	359 59 60
GPI	206 16 53	CS 2	140 27 51.5
CS 2	297 46 21		

