

TS-1014


Department of Lands

Integration of N.S.W. RECONNAISSANCE and MAINTENANCE REPORT 10/56

STATION TS 10158 GREEN SLOPES (P)

Co: BATHURST Ph: DRANGE
 Map Sheet: No:
 Inspected by: W.A. WATKINS Date: NOV 75
 Authority: DRANGE LBD Field Book: AR 427

Beacon Diagram Not to Scale

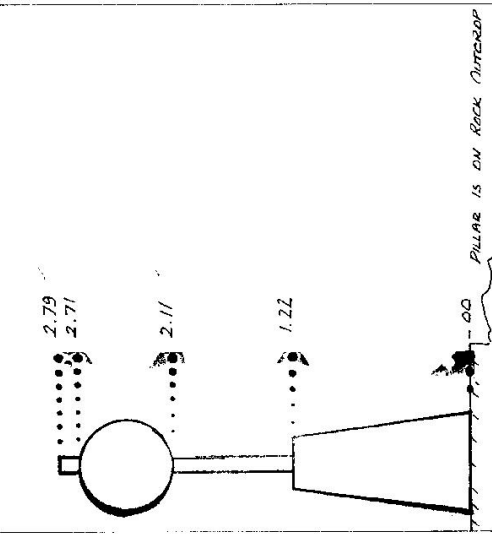

Date: 04/75
 Record of Station: PILLAR ERECTED

This Trig. Station has been: Note: Cross out word or words which do not apply

1. Completely cleared to permit 360° vision to surrounding Trigs, ~~SOME~~ **TREES DOWN SLOPES ABSTRACT VISION IN OTHER DIRECTIONS.**
2. Cleared by James bearing ~~from Trig-Mast~~
3. Trig. Mast & Vanes have been painted white & black respectively.
4. The Trig. was ~~erected~~ **not** unpiled, dimensions now being:

Description of mark **CONCRETE PILLAR** should be explicit, e.g. Steel plug, Brass plug, Bolt, Concrete Pillar
 Height of mark **1.22** m above ~~top~~ **rock/concrete** ~~below~~ **6-t.**
 Height of Top Vanes to Top Mark/Top pillar plate **1.49** m Diameter of Vanes (vertical) **0.60** m.

Height of Cairn **0** m. Diameter of Cairn **0** m.
 Length of Mast **1.57** m. (approximate if not unpiled)

5. A **set in conc/rock** has been placed/fd **0** m. bearing **0** M from Trig. Mast/pillar
6. A **set in conc/soil** has been placed/fd **0** m. bearing **0** M from Trig. Mast/pillar
7. A **set in conc/soil** has been placed/fd **0** m. bearing **0** M from Trig. Mast/pillar
8. A **set in conc/rock** has been placed/fd **0** m. bearing **0** M from Trig. Mast/pillar


9. Connection **to** **0** m. bearing **0** M
10. Connection **to** **0** m. bearing **0** M
11. Connection **to** **0** m. bearing **0** M
12. Connection **to** **0** m. bearing **0** M
13. Diff. Ht. **is** **0** m. ^{above} ~~below~~
14. Diff. Ht. **is** **0** m. ^{above} ~~below~~
15. Diff. Ht. **is** **0** m. ^{above} ~~below~~
16. Diff. Ht. **is** **0** m. ^{above} ~~below~~

Prepared by: *[Signature]* Checked: *[Signature]*

STATION TS 10158 & ENCLOSES (P)

Owners Name: SHYLL - SHARPE PASTORAL CO. Current Occupant: SHARPE JOHN TONY (SON)
 Address: 66 POWELL, KNOX, GERRARD & CO. Address: "WILLOW WOOD"
 TOWER BUILDING, ASST. SURVEYOR, SYDNEY IZELY ROAD, ORANGE
 PHONE G2 7808 (23 GREENHAYRE RD KILLARA 2533-6445)

Access NOV 1975
 00 CAR SUMNER ST EAST & IZELY ROAD IN ORANGE TAKE IZELY ROAD
 1-2 CANOVALAS HIGH SCHOOL ON RIGHT
 2-95 TURN RIGHT THRU GATE FOLLOW TRACK ON LEFT OF FENCE
 3-2 FOLLOW TRACK TO LEFT
 3-3 SWED ON LEFT FOLLOW TRACK
 3-8 TRACK VEERS RIGHT UP HILL
 3-9 THRU GATE
 4-0 DAM ON RIGHT FOLLOW TRACK TO TS.
 4-4 TS.

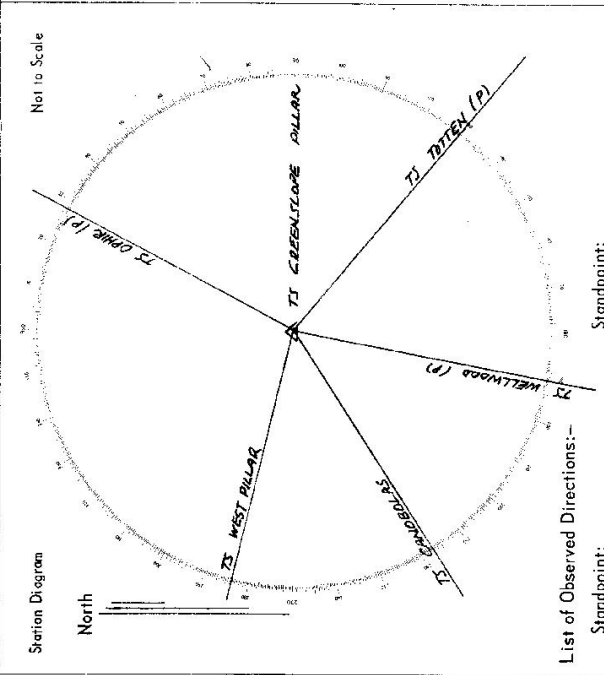

List of Observed Directions:-

Stationpoint:		Stationpoint:	
Station	Direction	Station	Direction

