

CENTRAL MAPPING AUTHORITY GEODETTIC SURVEY OF M.S.W.

GEODETTIC STATION RECONNAISSANCE and MAINTENANCE REPORT

STATION: **BOBLE GIGBIE** No.: **1016**

MAP SHEET SCALE 1:250 000 **NARRANDERA**

INSPECTED BY: **G. KEEP** DATE: **7-7-82**

AUTHORITY: **C.M.A.** FIELD BOOK:

Station Diagram

North

Not to Scale

Description:

1. Cleared by lanes bearing..... *Note: Cross out word or words which do not apply*

2. ~~Mast & Vanes have been painted white & black respectively~~..... from Trig. Mast

3. The station/pillar was unpiled/not unpiled/constructed on..... 19....., dimensions now being:
 Description of mark..... should be explicit, e.g., S/Steel Pillar Plate, Steel plug, Brass plug, Bolt, G.I. Pipe
 Height of mark.....m. ^{above} _{below} rock/concrete; Mark is.....m. ^{above} _{below} G.L.
 Height of Top Vanes to Top Mark/Pillar plate.....m. Diameter of Vanes (vertical).....m.
 Height of Cairn.....m. Diameter of Cairn.....m. Name Plate found/not found/placed,
 Length of Mast.....m. (approximate if not unpiled) Name imprinted on vanes only

4. A..... set in conc/rock has been placed/found, bearing.....° M from Mast/Plug/Pillar

5. A..... set in conc/rock has been placed/found, bearing.....° M from Mast/Plug/Pillar

6. A..... set in conc/rock has been placed/found, bearing.....° M from Mast/Plug/Pillar

7. A..... set in conc/rock has been placed/found, bearing.....° M from Mast/Plug/Pillar

8. Action required: **360° clearing of trees, complete rebuilding of station (including plug not found)**

STANDPOINT:				STANDPOINT:			
Mark	Direction	Horiz. Distance	Height Difference	Mark	Direction	Horiz. Distance	Height Difference
			above standpt.				above standpt.
			below				below standpt.
			above standpt.				above standpt.
			below				below standpt.
Prepared by: *Geoffrey Keep* 12/7/82 Checked: *Checked*

Noted on U.T.M. Card

Checked

SI 2733-2 D. West, Government Printer

STATION **BOBLEGICBIE** **1016**


Owner's Name:
 Address:
 Phone:
 Current Occupant:
 Address:
 Phone:

ACCESS

Access Report of 7.7.1985 was found suitable/unsuitable.

Condition of Geodetic Station:

Mast and vanes supported by discarded stump and some rocks. There is no visible remains of a cairn. Mast needs replacing, vanes in good condition. No plug found, no marks found. This geodetic station is situated on a low hill and requires 360° clearing of trees. For access, see Bogolong Hills 1:50,000.

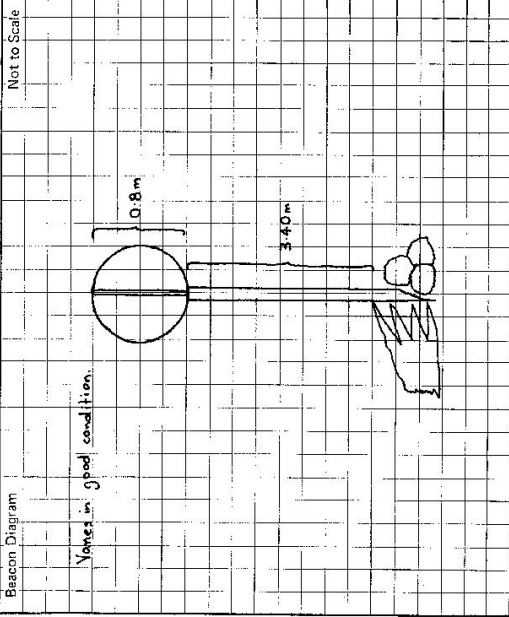

This section to be completed by officer constructing pillar.

Original station mark found/not found.

Description of mark:

Original beacon found/not found.

Description of beacon:

Height Top of Vanes to Top Mark:m.

Height of mark:m. above below
 rock/concm. above below
 G.L.

Diameter of Vanesm. Height of Cairnm.

Original Beacon has/has not been destroyed by me.

Date	Record of Station