

Integration: Key of N.S.W.

Department of Lands

RECONNAISSANCE and MAINTENANCE REPORT 10160

STATION 15 10160 SPRINGS MOUNT

This Trig. Station has been:

Note: Cross out words or words which do not apply

1. Completely cleared to permit 360° vision to surrounding Trigs, ~~SCATTERED~~ TREE TRIPLET ~~VISION IN SOME DIRECTIONS~~ FROM TRIG-MAST
2. Cleared by ~~lines-bearing~~
3. Trig. Mast & Vanes have been painted white & black respectively.
4. The Trig. was ~~emptied~~/not uplied, dimensions now being:


Description of mark: ~~CONCRETE PILLAR~~ STEEL PLUG, BRASS PLUG, BOLT, CONCRETE PILLAR  
 Height of mark: 1.23 m above ~~rock/concrete~~ G.L.  
 Height of Top Vanes to ~~Top Mark~~ Top pillar plate: 1.47 m Diameter of Vanes (vertical): 0.61 m.  
 Height of ~~Coin~~ Cap: m. Diameter of ~~Coin~~ Cap: m.

- Length of Mast: 1.56 m. (approximate if not uplied)
5. A. ~~65~~ set in conc/rock has been placed ~~44.3~~ 3.320 m. bearing ~~161~~ 161°M from Trig. Mast/pillar
  6. A. ~~69~~ set in conc/soil has been placed ~~44.3~~ 3.702 m. bearing ~~24~~ 24°M from Trig. Mast/pillar
  7. A. set in conc/soil has been placed ~~44~~ 3.702 m. bearing ~~0~~ 0°M from Trig. Mast/pillar
  8. A. set in conc/rock has been placed ~~44~~ 3.702 m. bearing ~~0~~ 0°M from Trig. Mast/pillar

9. Connection ~~65~~ to ~~69~~ 65 to 69 m. bearing ~~3~~ 3°M
10. Connection ~~to~~ to ~~to~~ m. bearing ~~0~~ 0°M
11. Connection ~~to~~ to ~~to~~ m. bearing ~~0~~ 0°M
12. Connection ~~to~~ to ~~to~~ m. bearing ~~0~~ 0°M
13. Diff. Ht. ~~65~~ is ~~1.396~~ 1.396 m. ~~above~~ below ~~ROCK~~ ROCK
14. Diff. Ht. ~~69~~ is ~~1.25~~ 1.25 m. ~~above~~ below ~~ROCK~~ ROCK
15. Diff. Ht. ~~is~~ is ~~is~~ m. ~~above~~ below
16. Diff. Ht. ~~is~~ is ~~is~~ m. ~~above~~ below

Prepared by: [Signature] Checked: [Signature]

Co: BATHURST | Ph: COLVILLE  
 Map Sheet: No:  
 Inspected by: W.A. WATKINS | Date: NOV 75  
 Authority: DEBARGE JBO | Field Book: AU 426  
 Beacon Diagram: Not to Scale

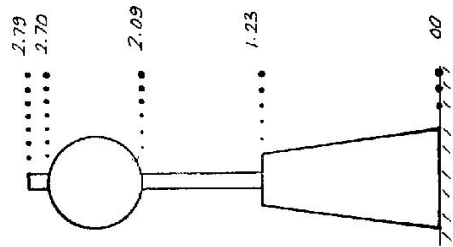

Date: OCT 75 | Record of Station  
 MAY 75 | ALAR ERECTED.  
 2nd DEGREE CONNECTION TO AMO

STATION TS 10160 SPRING MOUNT

Current Occupant: BENNETT J.M.

Owners Name: TARANGA PASTORAL CO


Address: TARANGA PH 68 7231

Address: SPRINGMOUNT VIA BLANNEY

Access

DO MILLINDERE P.D. TAKE ROAD TO BOTHUST VIA GUYONG AND VITONEM  
 11.2 GATE ON RIGHT, TAKE 20 M OFF ROAD.

Not to Scale

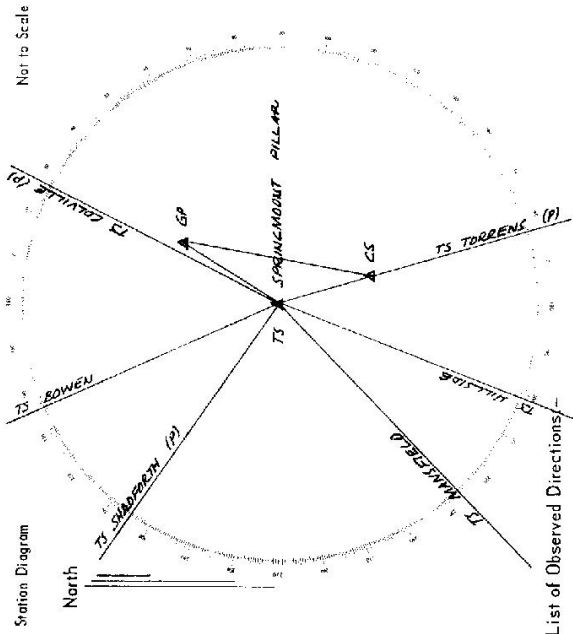

List of Observed Directions

Standpoint: ALLAR	
Station	Direction
TORRENS TS (P)	359 59 60
GP	82 56 04
CS	219 24 58.5
Standpoint: CS	
Station	Direction
TORRENS TS (P)	359 59 60
GP	82 56 04
SPRINGMOUNT TS (P)	186 00 00

