


Department of Lands
 Integration of N.S.W.
 RECONNAISSANCE and MAINTENANCE REPORT/CVE/ STATION
 HILLSIDE (P) TS 10161

Co: BATHURST Ph: TORRENS
 No: _____
 Inspected by: W.A. MARSH Date: Nov 75
 Authority: ORANGE LBO Field Book: PR 426
 Beacon Diagram Not to Scale

This Trig. Station has been: _____
 Note: Cross out words or words which do not apply

1. Completely cleared to permit 360° vision to surrounding Trigs.
2. Cleared by James bearing from Trig. Mast
3. Trig. Mast & Vanes have been painted white & black respectively.
4. The Trig. was unpiled/not unpiled, dimensions now being: _____
 Description of mark: CONCRETE PILLAR should be explicit, e.g. Steel plug, Brass plug, Bolt, Concrete Pillar
 Height of mark: 1.23 m above rock/concrete 1.23 m ^{above} G.L.
 Height of Top Vanes to Top-Mark Top pillar plate: 1.47 m Diameter of Vanes (vertical): 0.62 m.
 Height of Centre m. Diameter of Centre m.
5. A CS set in conc/rock has been placed/ft 3.284 m, bearing 136°M from Trig. Mast/pillar
6. A SP set in conc/soil has been placed/ft 3.198 m, bearing 16°M from Trig. Mast/pillar
7. A set in conc/soil has been placed/ft m, bearing °M from Trig. Mast/pillar
8. A set in conc/rock has been placed/ft m, bearing °M from Trig. Mast/pillar
9. Connection SP to CS 5.443 m, bearing 166°M
10. Connection to m, bearing °M
11. Connection to m, bearing °M
12. Connection to m, bearing °M
13. Diff. Ht. CS is 1.395 m, below PILLAR PLATE
14. Diff. Ht. SP is 1.103 m, below PILLAR PLATE
15. Diff. Ht. is m, above
16. Diff. Ht. is m, below

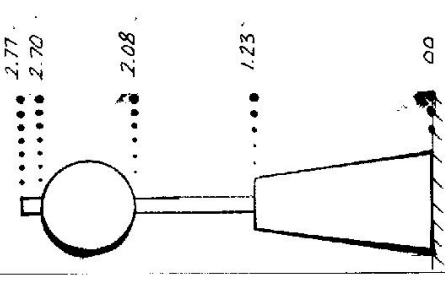

Date: OCT 75 Record of Station
PILLAR ERECTED
MAY 78 2nd ORDER CONNECTION TO AMD.



Prepared by: [Signature] Checked: [Signature]

STATION TS HILLSIDE (P)

Owners Name: STONE STREET, N.T. & M.M. Current Occupant:

Address: "HILLSIDE"
 EAST GUYONG.

Access NOV 1975
 0.0 ROAD JUNCTION ON MITCHELL HIGHWAY (BORNEO ST. CHANGE TO BURNLEY 18)
 TAKE BURNLEY ROAD TO BURNLEY AT "Y" JUNCTION. (BURNLEY IS MILEMARK 10)
 TURN LEFT TO BURNLEY AT "Y" JUNCTION. (BURNLEY IS MILEMARK 10)
 7.5 TURNING RIGHT HAND BEHIND TAKE TRACK AT AREA OF BEHIND ON
 8.6 LEFT THRU CAVE "HILLSIDE"
 9.2 FOLLOW TRACK THRU GATE WEST HAYFIELD
 9.4 OVER BRIDGE FOLLOW TRACK OVER DAM WEST HAYFIELD
 10.1 FOLLOW TRACK TO RIGHT BETWEEN HEDGE & SHED UP HILL
 10.4 T.S.

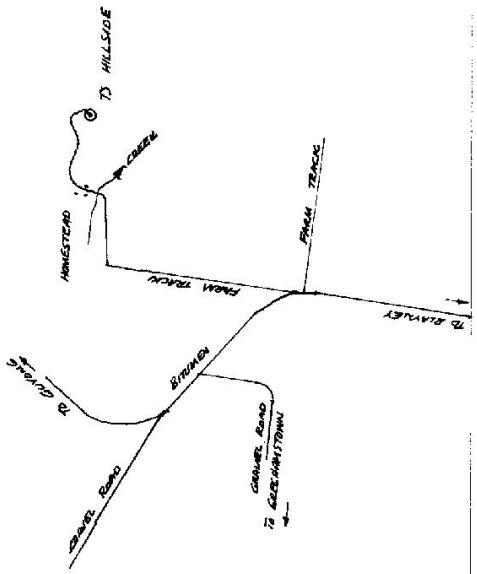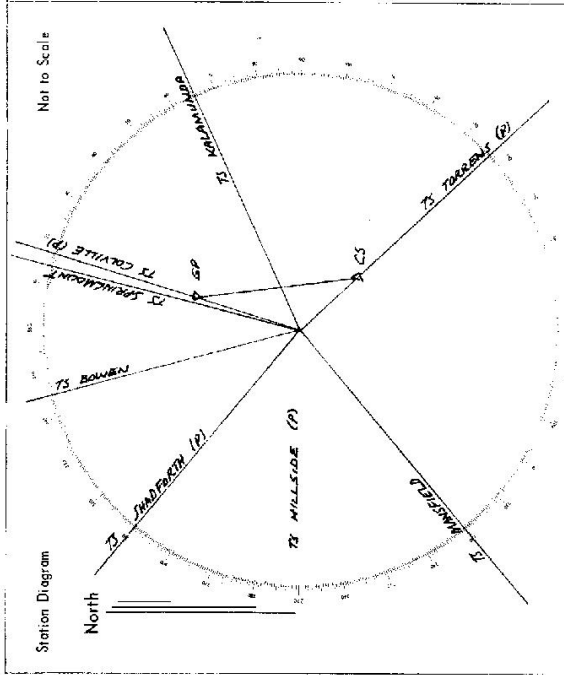

List of Observed Directions:-

Station	Direction	Station	Direction
		Standpoint: PILLAR	
		Station	Direction
		SANDFORD TS (P)	109 59 60
		GP	157 57 45.8
		CS	187 53 14.2
		Standpoint: GP	
		Station	Direction
		COLVILLE TS (P)	309 59 60
		CS	109 50 15
		HILLSIDE TS (P)	180 00 00