

7 x 10.3

Integration of N.S.W.

Department of Lands

RECONNAISSANCE and MAINTENANCE REPORT 10163

STATION 10163 WYOMING (P)

Note: Cross out word or words which do not apply

This Trig. Station has been:-


- 1. Completely cleared to permit 360° vision to surrounding Trigs.
- 2. Cleared by lanes-bearing from Trig. Mast
- 3. Trig. Mast & Vanes have been painted white & black respectively.
- 4. The Trig. was emptied/not unpiled, dimensions now being:
 Description of mark..... ~~CONCRETE PILLAR~~ should be explicit, e.g. Steel plug, Brass plug, Bolt, Concrete Pillar
 Height of mark..... 1.24 m above rock concrete 1.24 m above G.L.
 Height of Top Vanes to Top Mast/Top pillar plate 1.47 m Diameter of Vanes (vertical) 0.61 m.
 Height of Centre..... m. Diameter of Cap..... m.

- 5. A..... GP..... set in conc/rock has been placed/d 2.28 m, bearing v. 9M from Trig. Mast/pillar
- 6. A..... CS..... set in conc/rock has been placed/d 3.40 m, bearing v. 9M from Trig. Mast/pillar
- 7. A..... set in conc/soil has been placed/d m, bearing 9M from Trig. Mast/pillar
- 8. A..... set in conc/rock has been placed/d m, bearing 9M from Trig. Mast/pillar
- 9. Connection..... CS to..... GP..... bearing..... 192 v. 9M
- 10. Connection..... to..... m, bearing..... 9M
- 11. Connection..... to..... m, bearing..... 9M
- 12. Connection..... to..... m, bearing..... 9M
- 13. Diff. Ht. GP is 1.319 m above PILLAR PLATE
- 14. Diff. Ht. CS is 1.473 m above PILLAR PLATE
- 15. Diff. Ht. is m. above
- 16. Diff. Ht. is m. above

Prepared by: *[Signature]* Checked: *[Signature]*

Map Sheet: No: NAPIER
 Inspected by: W.A. WATKINS Date: NOV 75
 Authority: ORANGE LBO Field Book: RU 425

Beacon Diagram Not to Scale

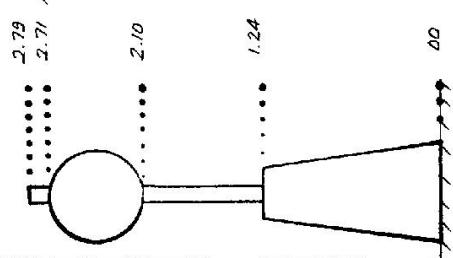


Date	Record of Station
OCT 75	PILLAR ERECTED.

STATION TS 10163 WYOMING (P)

Owners Name: PREIS, M.L. Current Occupant: _____

Address: "WYOMING" BLATNEY

Access: NOV 1975
 00 BLATNEY POST OFFICE. TAKE EVENTS ST INTO NEWBOROUGH ROAD
 4.9 TAKE GORBEL ROAD STRAIGHT ON. BITUMEN TRAILS TO RIGHT.
 5.7 OVER RAILWAY BRIDGE FOLLOW ROAD.
 6.1 TURN LEFT THRU GATE "WYOMING 1/2 MI L. PREIS."
 7.1 TURN LEFT THRU GATE TO "WYOMING". FOLLOW WELL DEFINED TRACK PAST HOUSE AND SHEDS TO TS.

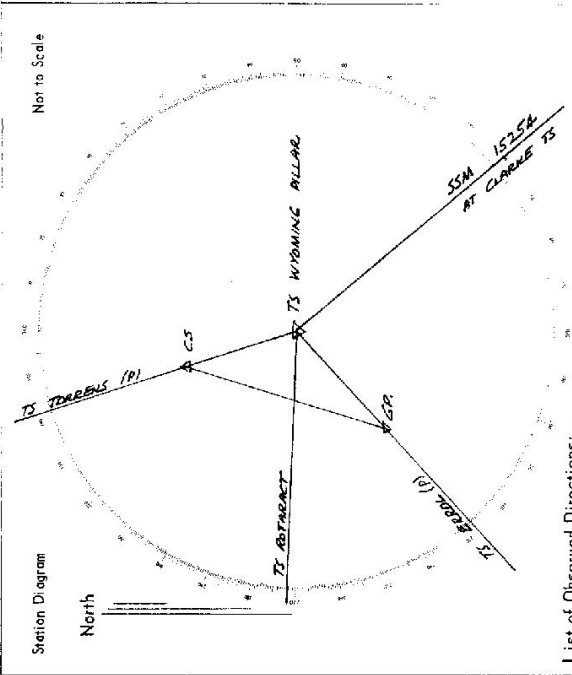

List of Observed Directions:-

Standpoint:		PILLAR.	
Station	Direction	Station	Direction
		ERRAL TS (P)	189 59 60
		GP	0 00 00
		CS	115 41 15.2
Standpoint:		CS	
Station	Direction	Station	Direction
		TORRENS TS (P)	189 59 60
		WYOMING TS (P)	180 00 00
		GP	212 57 43

STATION WYOMING TS 10163	Owner's Name Mr. W.L. Press Address Wyoming Blayne Phone:	Current Occupant: Address: Phone:
ACCESS 16 - 12 - 1987		
Access Report of 11/15/75 was found unsuitable unsuitable . Km 0.0 From Blayne Post Office take Burns Street (Newbridge Road). 2.4 Cross over railway bridge. 4.0 Cross under railway bridge (subway). 4.95 At road intersection go straight ahead on gravel road (parallel railway). 5.7 Cross railway bridge. 6.1 Turn left along dirt road at mail boxes "Wyoming and "Kapunda" 7.0 At fork in road, take left fork. 7.05 Cross grid. 7.45 Pass through gate and turn right along well-defined track. 7.75 Pass through gate taking faint track to left across grassed paddock. 8.0 Pass through gate. 8.2 Pass through gate. 8.5 Turn left and up faint track 8.5 Wyoming (P) 10m from concrete water tank.		
Beacon Diagram: Not to Scale 	This section to be completed by officer constructing pillar. Original station mark found/not found.	Description of mark: Original beacon found/not found. Description of beacon: Height: Top of Vanes to Top Mark m. Height of mark m. above G.L. below Diameter of Vanes m. Height of Cairn m. Original Beacon has/has not been destroyed by me.
Date: _____ Record of Station: _____		