

CENTRAL MAPPING AUTHORITY  
Department of Lands

Trigonometrical Survey of N.S.W.

RECONNAISSANCE & MAINTENANCE REPORT

STATION TS 10165  
Co: GLoucester Ph: FORSTER  
Map Sheet: FORSTER 1:25000 No: 9433-IV-5  
Inspected by: T. ST GEORGE Date: 3<sup>RD</sup> AUG 1977  
Authority: DEPT OF LANDS Field Book: \_\_\_\_\_

This Trig. Station has been:-


1. Completely cleared to permit 360° vision to surrounding Trigs.
2. Cleared by lines-bearing from Trig. Mast.
3. Trig. Mast & Vanes have been painted white & black respectively.
4. The Trig. was unpiled/not unpiled, dimensions now being:  
Description of mark METAL OBSERVING PILLAR should be explicit, eg. Steel plug, Brass plug, Bolt, G.I. Pipe  
Height of mark.....m above rock/concrete.....m above G.L.  
Height of Top Vanes to Top MARK 1.475 m. Diameter of Vanes (vertical) 0.595 m.  
Height of Cairn.....m. Diameter of Cairn.....m.  
Length of Mast 1.555 m. (approximate if not unpiled)

5. A.....set in conc/rock has been placed.....m. bearing.....°M from Trig. Mast
6. A.....set in conc/soil has been placed.....m. bearing.....°M from Trig. Mast
7. A.....set in conc/soil has been placed.....m. bearing.....°M from Trig. Mast
8. A.....set in conc/rock has been placed.....m. bearing.....°M from Trig. Mast
9. Connection.....to.....m. bearing.....°M
10. Connection.....to.....m. bearing.....°M
11. Connection.....to.....m. bearing.....°M
12. Connection.....to.....m. bearing.....°M
13. Diff. Ht. .... is.....m. above.....m. below.....°M
14. Diff. Ht. .... is.....m. above.....m. below.....°M
15. Diff. Ht. .... is.....m. above.....m. below.....°M
16. Diff. Ht. .... is.....m. above.....m. below.....°M

Prepared by: T. ST GEORGE Checked: \_\_\_\_\_

Noted on U.T.M. Card

Beacon Diagram Not to Scale

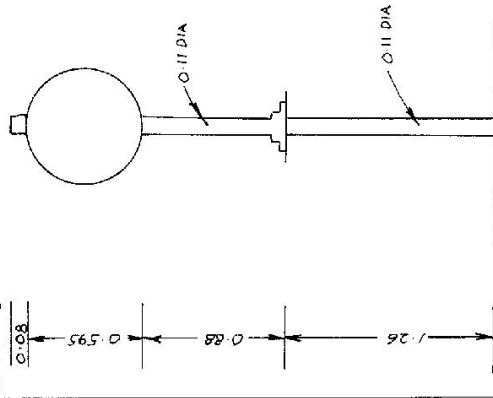

Date 3/8/77 Record of Station  
CHECKED T. ST GEORGE STAFF SURVEYOR

Checked

