

STATION TS 10168 ROWETH (P)


Owners Name ESTATE OF GEORGE ROWETH Current Occupant ROWETH H.W.

Address " BELLEVUE " Address " BELLEVUE "

SPRING HILL SPRING HILL

Nov 1975

Access 00 ROAD JUNCTION ON MITCHELL HIGHWAY 13 K EAST OF CHANGE. TAKE ROAD SOUTH TOWARDS BLANNEY.
 3.3 ROAD JUNCTION (DAMAGE TO RIGHT) STRAIGHT ON.
 3.6 TURN LEFT ONTO DIRT TRACK. CONTINUE LEFT TO GATE. THEN GATE & FOLLOW TRACK.
 3.8 TURN RIGHT THRU GATE "BELLEVUE" ALONG TRACK.
 4.0 PROCEED THRU GATE. HOLD ON LEFT.
 4.2 THRU WOODEN GATE THEN RIGHT DOWN ARBOUR.
 4.3 TURN LEFT ACROSS Paddock.
 4.4 TS.

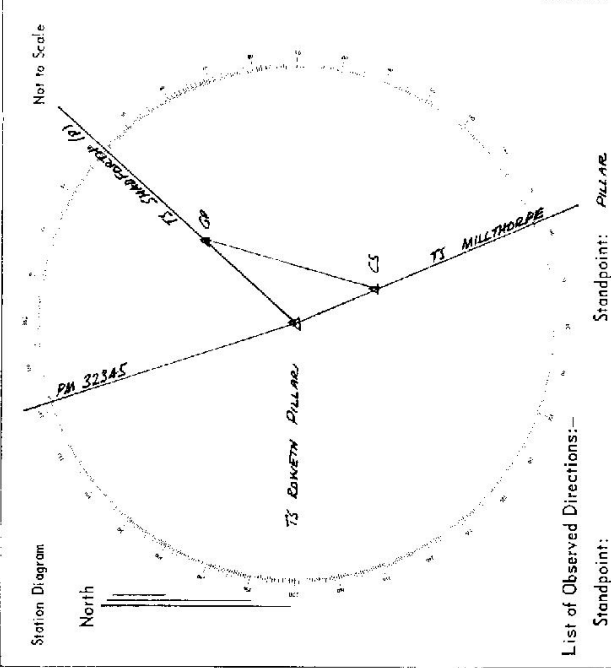

List of Observed Directions:-

Standpoint:		PILLAR	
Station	Direction	Station	Direction
		MILLTHORPE TS	353 59 60
		CS	0 00 00
		GP	246 21 147
Standpoint:		GP	
Station	Direction	Station	Direction
		SANDFORTH TS (P)	329 59 60
		CS	145 21 09
		ROWETH TS (P)	180 00 00