


STATION BYNG TS 10169

Owners Name: **PENDARVES DEV. CO. PTY. LTD** Current Occupant: **MANICE A.V.**
 Address: **"PENDARVES"** Address: **"PENDARVES"**
BYNG **BYNG**

NOV 1975
 INTERSECTION OF MITCHELL HIGHWAY AND BYNG ROAD 3.3K EAST OF LUGBOWN
 THREE DIAL ROAD.
 2.4 BITUMEN ROAD FOLLOW BITUMEN
 2.8 GRAVEL ROAD FOLLOW GRAVEL
 4.2 T JUNCTION GO LEFT
 5.6 T JUNCTION THRU RIGHT
 5.9 THRU RIGHT THRU DOUBLE GATES AT UNOLISHED
 6.7 PARAS FOLLOW TRAIL THRU MODERN CARP
 THESE LEFT HAND PARAS.
 6.8 TRAIL ON RIGHT FOLLOW TRACK
 7.4 GOALY ON LEFT FOLLOW GULLY TO TS.
 7.8

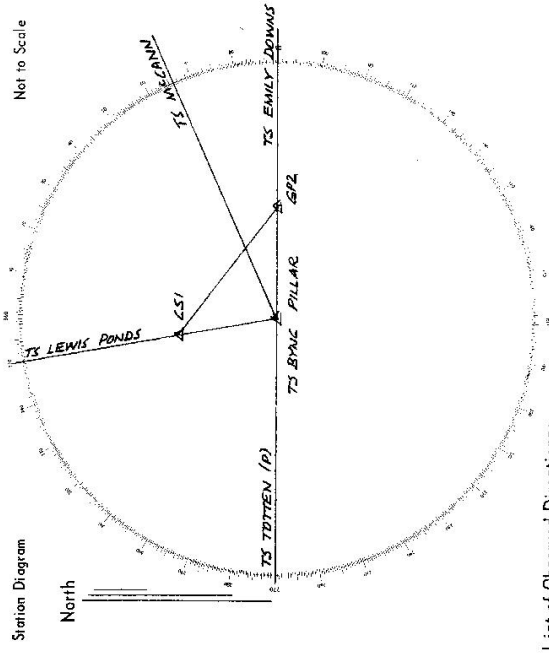

List of Observed Directions:-

Standpoint: PILLAR	
Station	Direction
TOTTEN TS (P)	359 59 60
CS1	80 43 03.7
GP2	180 52 20.6
STANDPOINT: CS1	
Station	Direction
LEWIS POND TS	359 59 60
GP2	136 47 44

