

Department of Lands

RECONNAISSANCE and MAINTENANCE REPORT

STATION

LENEHAN (P)

This Trig. Station has been:-

Note: Cross out word or words which do not apply

1. Completely cleared to permit 360° vision to surrounding Trigs.
2. Cleared by ~~lines-bearing~~ from Trig. Mast
3. Trig. Mast & Vanes have been painted white & black respectively.
4. The Trig. was ~~unpiled~~ not unpiled, dimensions now being:

Description of mark CONCRETE PILLAR should be explicit, e.g. Steel plug, Brass plug, Bolt, Concrete Pillar
 Height of mark 1.24 m ^{above} ~~below~~ rock concrete 1.24 m ^{above} ~~below~~ G.L.
 Height of Top Vanes to ~~Top Mark~~ Top pillar plate 1.48 m Diameter of Vanes (vertical) 0.61 m.
 Height of ~~Centre~~ Centre m. Diameter of ~~Centre~~ Centre m.

Length of Mast 1.56 m. (approximate if not unpiled)
 5. A GP set in conc. ~~rock~~ has been placed at 3.558 m. bearing 126 °M from Trig. ~~Mast~~ pillar
 6. A CS set in conc. ~~soil~~ has been placed at 3.931 m. bearing 228 °M from Trig. ~~Mast~~ pillar
 7. A CS set in conc./soil has been placed at m. bearing °M from Trig. Mast/pillar
 8. A CS set in conc./rock has been placed at m. bearing °M from Trig. Mast/pillar

9. Connection PILLAR to GP PL 3.889 m. bearing 282 °M UNIVERSITY TRIG " BUSHRANGER "
 10. Connection CS to GP 5.642 m. bearing 86 °M


11. Connection CS to GP PL 3.490 m. bearing 335 °M
 12. Connection GP to GP m. bearing °M

13. Diff. Ht. GP is 1.511 m. ^{above} ~~below~~ PILLAR PLATE
 14. Diff. Ht. CS is 1.247 m. ^{above} ~~below~~ PILLAR PLATE
 15. Diff. Ht. GP PL is 1.164 m. ^{above} ~~below~~ PILLAR PLATE
 16. Diff. Ht. GP is 1.164 m. ^{above} ~~below~~ PILLAR PLATE

Prepared by: K. L. ... Checked: ...

Co: BATHURST Ph: GRANTHAM
 Map Sheet: No:
 Inspected by: W. A. MATKINS Date: Nov 75
 Authority ORANGE LBO Field Book: 987 666

Beacon Diagram

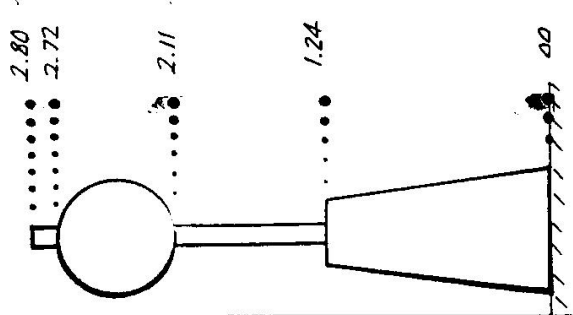

Not to Scale

Date	Record of Station
<u>OCT 75</u>	<u>PILLAR ERECTED</u>

STATION TS 10171 LENEHAN (P)

Current Occupant

Owners Name LENEHAN B.G.

Address

HARRINGTON


GEORGES PLAINS

Access NOV 1975

GO BRIDGE HOTEL PERTHVILLE TAKE ROAD TOWARDS BLANEY & GEORGES PLAINS.

- 0.05 CROSS RAILWAY
- 2.2 TURN RIGHT UP BITUMEN ROAD
- 3.6 FOLLOW UP DIRT ROAD
- 3.7 GRID. GO THRU FOLLOW TRACK
- 4.8 THRU GATE FOLLOW TRACK ALONG FENCE
- 6.1 THRU GATE BY CATTLE YARDS FOLLOW TRACK TO RIGHT
- 6.8 THRU GATE TAKE HELL WORN TRACK
- 7.5 GATE. DONT GO THRU HARD RIGHT & FOLLOW FENCE TO TRIG
- 7.9 T.S.

Station Diagram Not to Scale

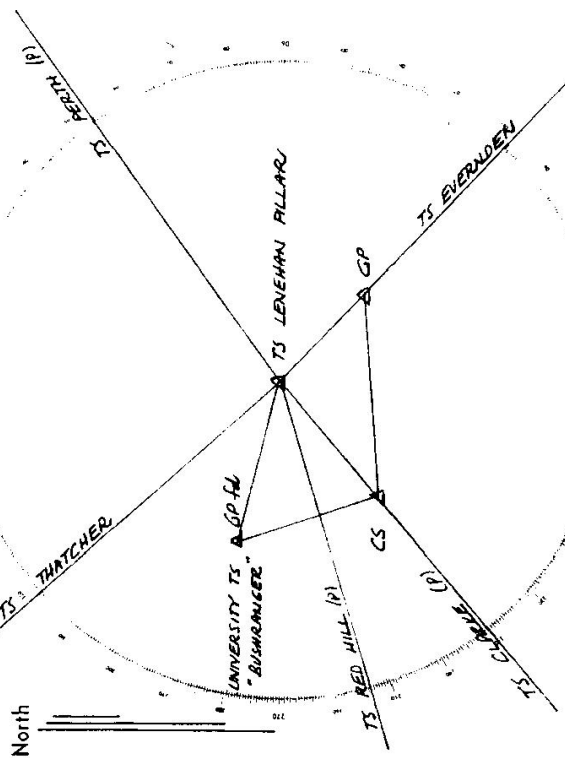

List of Observed Directions:-

Standpoint:		Standpoint: PILLAR	
Station	Direction	Station	Direction
		THATCHER TS	359 59 60 ✓
		GP	175 06 46.8 ✓
		CS	272 42 39.1 ✓
		GP HL	325 42 23 ✓
Standpoint: CS			
Station	Direction	Station	Direction
		CLARKE TS (P)	359 59 60 ✓
		GP HL	117 09 30 ✓
		LENEHAN TS (P)	180 00 00 ✓
		GP	218 40 42 ✓