
e e e	•	T
Department of Lands  RECONNAISSANCE and MAINTENANCE REPORT 10.72   STATION	4.7/W.7	
This Trig. Station has been:- Note: Cross out ward or wards which do not apply	Co. BATHURST Ph. BING	- 12
	Map Sheet:	
1. Completely cleared to permit 360° vision to surrounding Trigs.	Inspected by: M. A. WATKINS Date: Nov 75	
2. Cleared by lanes-bearingfrom Trig. Wast	Authority DRANCE 1BD. Field Book: My -426	
3. Trig. Mast & Vanes have been pointed white & black respectively.	Beacon Diagram Not to Scale	
4. The Trig. was unpiled/not unpiled, dimensions now being:		
Description of mark	2.74	
Height of mark		
Height of Top Vanes to T <del>op Mark</del> Top pillar plate	2.13	
Height of Cairn		
Length of Mast		
5. AG.P. set in concided has been placed 44 2.350 m. bouring 270 PM from Trig. Mast pillar	70	
6. A65. set in conc/soil has been placed to 2.719 m. bearing359 % Iron Trig. Mast/pillar		
7. A set in conc/soil has been placed/fdm. bearing "M from Trig. Mast/pillar		
8. Aset in conc/rock has been placed/fd m. bearing		
9. Connection 65 10 68 64.386. m. bearing 221 M.		
10. Connection to ; m. bearing	00 000	
11, Connectionto	Date   Record of Station	
12. Connection	PILLAR ERECTED	
.si		
14. Diff. Ht. 65 is. 1.233 /m. Press. B. 1975		
15. Diff. Ht		4
16. Diff. Hr. is. m. cowe		
Prenored by: - Checked: Medage		
		_

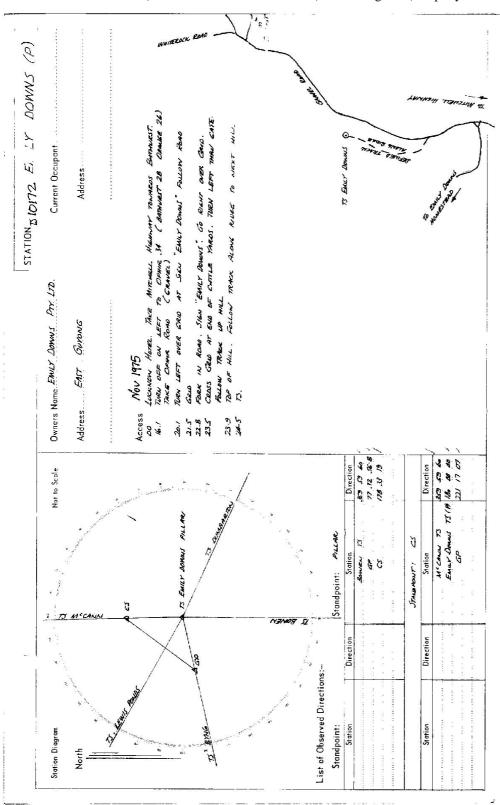

SECOPETIC STATION RECONNAISSANCE and MAINTENANCE REPORT  Mote: Cross out word or words which do not apply  More cross out word or words which do not apply  Mark is. L. 19.2.1., dimensions now being:  Mark is. L. 2.6	F	STATION: EMILY DOWN (P) No.: 1017Z	MAP SHEETS BATHURST SCALE 1:100 000 SCALE 1:250 000 BATHURST	INSFECTED BY: J. Suffer DATE: 7-8-87	AUTHORITY: CMA FIELD BOOK: —	330 340 350 360 10 20 350	Station Diagram North North	Q	900	265'0		0.8941	588.0	80	+	4 0.32m sq 8		02.7 02.7	120	7 -19 (-1	360	_	,	46	210 / 200 / 190   190   190 / 160 / 150	7
GEODETIC STATION RECONNAIS  GEODETIC STATION RECONNAIS  Seen painted white & black respectively.  Silface Mark Pillar plate	DETIC SURVEY OF N.S.W.			2000	<u>                                     </u>	19.28.7 dimensions now being:			(vertical) 0595.m.	Name Plate found/ <del>not found/placed.</del>	<u> </u>		1.272 M from Mast/Plug/Piller 2. Scmdishad			1 1	Ì	Direction Horiz. Height Difference		_ \		above standpt.	above standpt.	above standpit.	above standpt.	- C
	CENTRAL MAPPING AUTHORITY GEODI	GEODETIC STATION RECONNAISS.		200	e been painted white & black respectively.	was unpiled/not unpiled/senstructed on	rk. Fillac. Platsshould be explicit, e.g., S/Steel Pillar P	232m. above roels/concrete; Mark is1.26	.492 m.	Height of Cairn	1.555	set in conc <del>/reek</del> has been <del>placed</del> /found, bearing.	matrice in conc/reek has been placed/found, bearing.	set in conc/rock has been placed/found, bearing.	set in conc/rock has been placed/found, bearing.	Painting of pillar, most & vares	STANDPOL	Horiz. Height Difference	above standpt.	above standpr.	above standpt	above standpt.	alcove standpr.	above standpt.	above standpt.	11 1 1 1

Content Company Name FASHES. GS & NAL  Address: CANNAY Docume.  Address
--