


STATION **MINCHINBURY (P)** TS 10193

Owners Name.....
 Current Occupant.....
 Address.....
 Access.....

Not to Scale

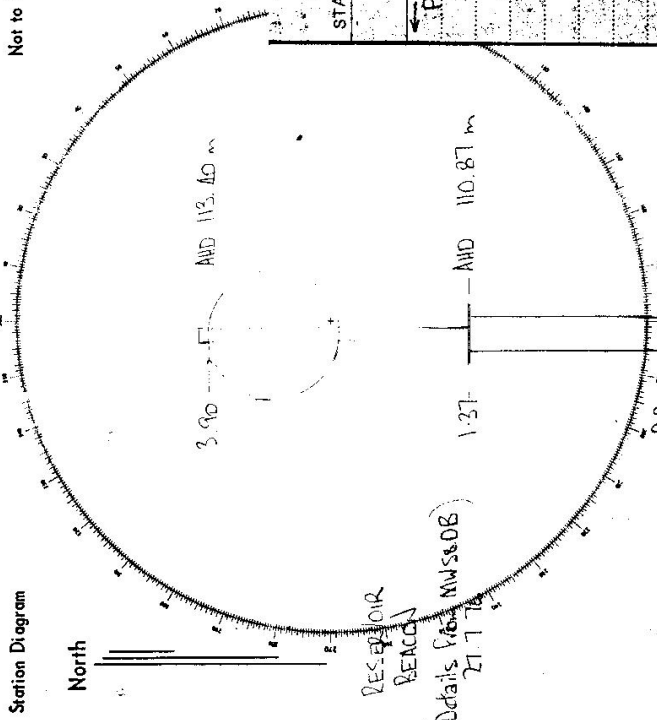

STATION **MINCHINBURY P.E.S.** R. 263

To

Remarks

← Paritth GREAT WESTERN HIGHWAY Eastern Ck →

WESTERN FREEWAY (F4)


CHATS WORTH RD

PIONEER CONCRETE PLANT

WALGROVE RD

UNIVERSAL KEY

Note: B.M. found GI spike in tree; blazed Δ painted BMA 302.09.

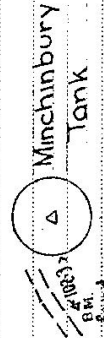

List of Observed Directions:-

Standpoint:		Standpoint:	
Station	Direction	Station	Direction

M. Ref Liverpool Military Sheet 1:63,361
 E 382 800 N 824 400 yds