

CENTRAL MAPPING AUTHORITY

GEODETIC SURVEY OF N.S.W.

GEODETIC STATION RECONNAISSANCE and MAINTENANCE REPORT

Description:

Note: Cross out word or words which do not apply

1. Cleared by lanes bearing..... from Trig/Mast
2. Mast & Vanes have been painted white & black respectively.
3. The station/pillar was unpiled/not unpiled/constructed on..... 19....., dimensions now being:
Description of mark..... should be explicit, e.g., S/Steel Pillar/Plate, Steel plug, Brass plug, Bolt, G.I. Pipe
Height of mark..... m, above rock/concrete; Mark is..... m, above G.L.
Height of Top Vanes to Top Mark/Pillar plate..... m. Diameter of Vanes (vertical)..... m.
Height of Cairn..... m. Diameter of Cairn..... m. Name Plate found/not found/placed.
Length of Mast..... m. (approximate if not unpiled)
4. A..... set in conc/rock has been placed/found, bearing.....° M from Mast/Plug/Pillar
5. A..... set in conc/rock has been placed/found, bearing.....° M from Mast/Plug/Pillar
6. A..... set in conc/rock has been placed/found, bearing.....° M from Mast/Plug/Pillar
7. A..... set in conc/rock has been placed/found, bearing.....° M from Mast/Plug/Pillar
8. Action required:.....

STANDPOINT:

STANDPOINT:

Mark	Direction	Horiz. Distance	Height Difference	Mark	Direction	Horiz. Distance	Height Difference
			above standpt				above standpt
			below				below
			above standpt				above standpt
			below				below
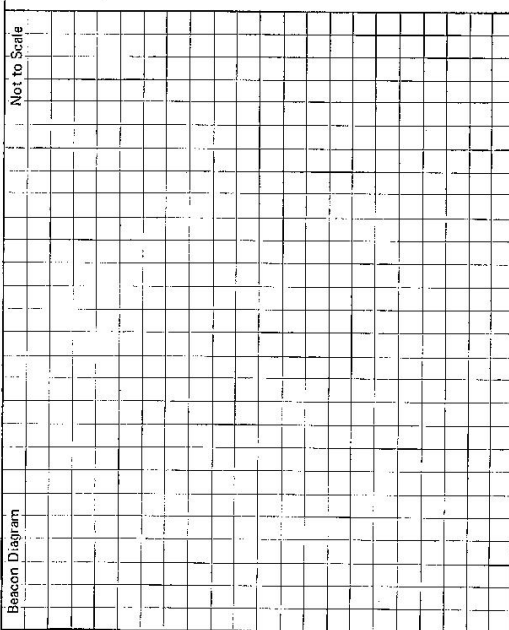
Prepared by: *G. Hanna* 7/7/80 Checked: *G. Hanna* 3/12/80

Noted on U.T.M. Card *G. Hanna* 24/11/81 Checked

Sr: 2733-1

STATION: BOBUNDARA No.: 1020
 MAP SHEET SCALE 1:250 000 BEGA
 INSPECTED BY: G. C. HANNIF DATE: 7/7/80
 AUTHORITY: C.M.A. FIELD BOOK:

St 2728 - 2 D. West, Government Printer

STATION	BOBUNDARA	1020
<p>Owner's Name:</p> <p>Address:</p> <p>Phone:</p> <p>Current Occupant:</p> <p>Address:</p> <p>Phone:</p> <p>Access Report of <u>1.1.1988</u> was found suitable/unsuitable.</p> <p><u>ACCESS</u></p> <p><u>Access (km)</u> See also Myalla 8725 - III - S</p> <p>O-O Cooma P.O. towards Bombala.</p> <p>1-35 R.H. turn towards Babundara.</p> <p>28-4 L.H. turn into property</p> <p>28-55 Homestead.</p> <p>28-75 Swing left.</p> <p>28-8 Take track to right.</p> <p>28-92 Take track to right.</p> <p>29-04 Sheds</p> <p>29-25 Wire gate. Park truck & walk to trig</p> <p>15 minute walk to trig.</p> <p>C, M & V found.</p> <p>M & V needs point.</p> <p>Light to medium cleaning required.</p>	<p>Not to Scale</p>  <p>This section to be completed by officer constructing pillar.</p> <p>Original station mark found/not found.</p> <p>Description of mark:</p> <p>Original beacon found/not found.</p> <p>Description of beacon:</p> <p>Height Top of Vanes to Top Markm.</p> <p>Height of markm. above below G.L.</p> <p>rock/conem. below</p> <p>Diameter of Vanesm. Height of Cairnm.</p> <p>Original Beacon has/has not been destroyed by me.</p>	<p>Date</p> <p>Record of Station</p>