



PM .....  
 TS 10201  
 (DURAL TELECOM TOWER)  
 M<sub>S</sub>M .....

See also PM 41858


**LOCALITY SKETCH PLAN**

Parish SOUTH COLAH County CUMBERLAND City or Town DURAL

Municipality or Shire HORNSBY Control Survey Plan DURAL U-0067-VIII

Measurements are in metres

Zone 56/1

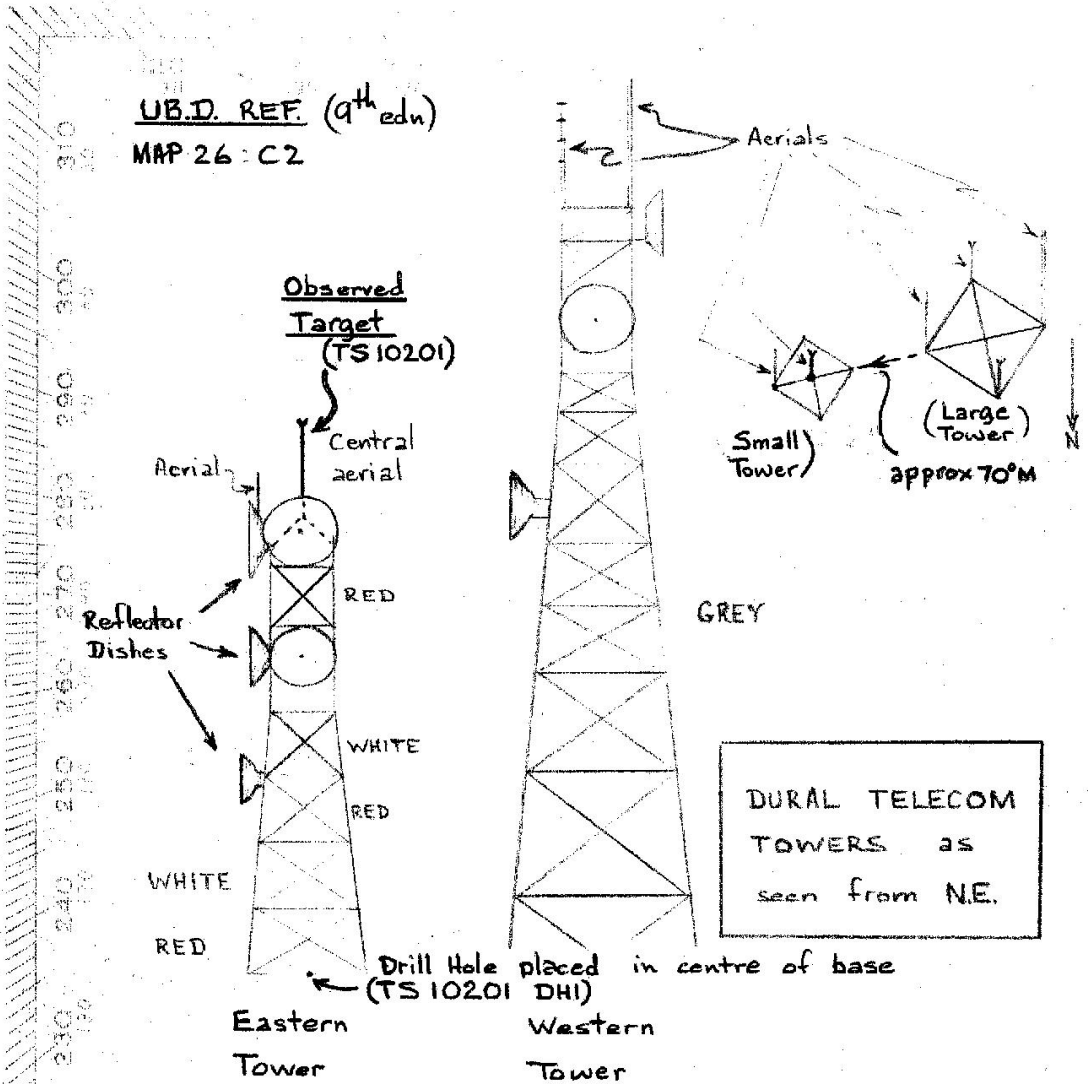

Organisation placing Marks

I certify that the Mark or Marks have been placed and numbered as detailed hereon.

Aerial photo No. .... Run .....  
 Plan registered / / 19  
 Mark last inspected / / 19

Book 2397

PM .....  
 TS 10201  
 M<sub>S</sub>M .....

*[Signature]*

Trig. Surveyor (Integration)  
 Designation

2.

DURAL TELECOM TOWER



PM .....  
 TS 10201 .....  
 (DURAL TELECOM TOWER)  
 M/M .....

See also PM 41858


**LOCALITY SKETCH PLAN**

Parish SOUTH COLAH County CUMBERLAND City or Town DURAL

Municipality or Shire HORNSBY Control Survey Plan DURAL U-0067-VII

Measurements are in metres

Zone 56/1

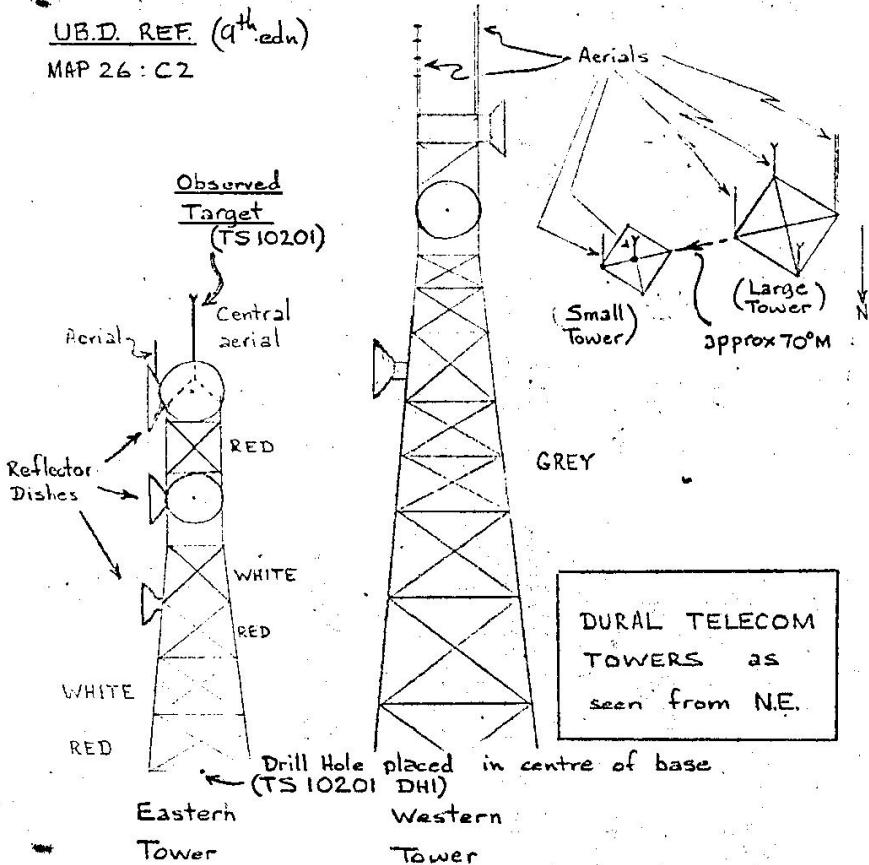

\* For Location see back page

Organisation placing Marks

I certify that the Mark or Marks have been placed and numbered as detailed hereon.

Aerial photo No. .... Run .....  
 Plan registered / / 19  
 Mark last inspected / /  
 2397

PM .....  
 TS 10201 .....  
 M/M .....

*[Signature]*  
 Trig. Surveyor (Registration)  
 Designation