

Department of Lands: Integrati of N.S.W. RECONNAISSANCE and MAINTENANCE REPORT 10207 STATION GLOSSOP (P) TS 10207

Co: COCK Ph: WOODWARD No:
 Inspected by: C. W. STARKLEY Date: 13/6/15
 Authority Dept: Lands Field Book: Geom 250
 Beacon Diagram Not to Scale

This Trig. Station has been: Map Sheet:


1. Completely cleared to permit 360° vision to surrounding Trigs.
2. ~~Cleared by hence bearing~~..... from Trig. Mast
3. Trig. Mast & Vanes have been painted white & black respectively.
4. The Trig. was unpiled/~~not erected~~, dimensions now being:
 Description of mark..... Concrete pillar should be explicit, e.g. Steel plug, Brass plug, Bolt, Concrete Pillar
 Height of mark..... 1.2 m above ~~rock~~ rock/concrete m above ^{below} G.L.

Height of Top Vanes to ~~Top Mast~~ Top pillar plate 1.17 m Diameter of Vanes (vertical) 0.6 m.
 Height of ~~Carm~~..... m. Diameter of ~~Carm~~..... m.

5. A..... set in conc/rock has been placed/fd m. bearing°M from Trig. Mast/pillar
6. A..... set in conc./soil has been placed/fd m. bearing°M from Trig. Mast/pillar
7. A..... set in conc./soil has been placed/fd m. bearing°M from Trig. Mast/pillar
8. A..... set in conc/rock has been placed/fd m. bearing°M from Trig. Mast/pillar

9. Connection..... to..... m. bearing.....°M
10. Connection..... to..... m. bearing.....°M
11. Connection..... to..... m. bearing.....°M
12. Connection..... to..... m. bearing.....°M
13. Diff. Ht. is..... m. ^{above} ~~below~~
14. Diff. Ht. is..... m. ^{above} ~~below~~
15. Diff. Ht. is..... m. ^{above} ~~below~~
16. Diff. Ht. is..... m. ^{above} ~~below~~

Prepared by: C. STARKLEY Checked: SA

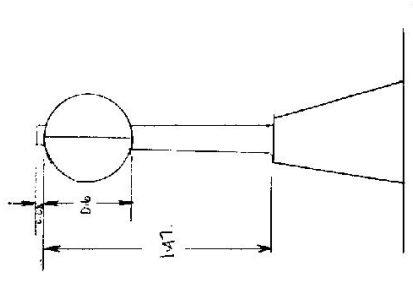

Date	Record of Station


STATION GLOSE & (P) TS 10207

Owners Name Current Occupant.....

Address Address

Access At Woodford 13-6-1979

Take Glossop Rd which runs north off Great Western highway about 2.5km east of Woodford Railway Station. Follow this road for about 2.5 km to TS.

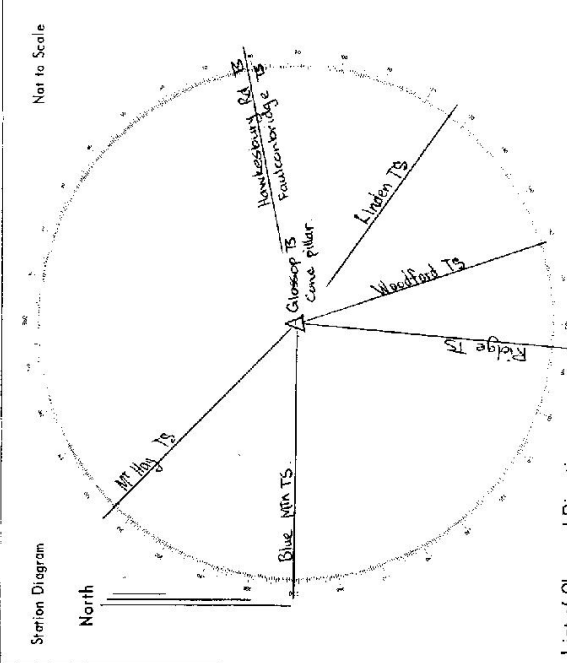

List of Observed Directions:-

Standpoint: Pillar		Station	Direction	Station	Direction
Blue Mt TS	0° 00' 00"				
Mt Holly TS	44° 59' 00"				
Frankston Rd TS	105° 47' 15"				
Frankston TS	176° 16' 42"				
Linden TS	216° 59' 52"				
Woodford TS	259° 31' 01"				
Ridge TS	275° 39' 01"				