

75-013

Integration of N.S.W.

Department of Lands

RECONNAISSANCE and MAINTENANCE REPORT (O-212)

STATION

RODGERS (P)

This Trig. Station has been:-

Note: Cross out words or words which do not apply


1. Completely cleared to permit 360° vision to surrounding Trigs.
2. Cleared by James-bearing
3. Trig. Mast & Vanes have been painted white & black respectively. from Trig. Mast
4. The Trig. was unpiled/~~rest-unsupported~~, dimensions now being:
 - Description of mark: ~~Concrete Pillar~~ should be explicit, e.g. Steel plug, Brass plug, Bolt, Concrete Pillar
 - Height of mark: 1.22 m ~~above~~ ~~concrete~~ 1.22 m above G.L.
 - Height of Top Vanes to Top Hook/Top pillar plate: 1.47 m Diameter of Vanes (vertical): 0.68 m.
 - Height of Cairn: Diameter of Cairn: m.
 - Length of Mast: m. (approximate if not unpiled)
5. A Trig. plug set in conc/rock has been placed/fd 4.46 m bearing 106° from Trig. Mast/pillar
6. A set in conc/soil has been placed/fd m. bearing °M from Trig. Mast/pillar
7. A set in conc/soil has been placed/fd m. bearing °M from Trig. Mast/pillar
8. A set in conc/rock has been placed/fd m. bearing °M from Trig. Mast/pillar
9. Connection to m. bearing °M
10. Connection to m. bearing °M
11. Connection to m. bearing °M
12. Connection to m. bearing °M
13. Diff. Ht. Old trig. plug is 1.41 m. ~~above~~ ~~below~~ Top pillar plate
14. Diff. Ht. is m. ~~above~~ ~~below~~
15. Diff. Ht. is m. ~~above~~ ~~below~~
16. Diff. Ht. is m. ~~above~~ ~~below~~

Map Sheet: No: _____

Inspected by: L.M. HAYES Date: JUNE 1975

Authority: DEPT OF LANDS Field Book: 3A

Beacon Diagram: 3A 521 Not to Scale

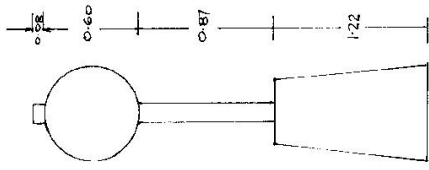

Date	Record of Station
Dec 1976	Connection to Rodgers Tower see new code

Prepared by: S. SPARKLEY Checked: J. ...

7-10-19

Department of Lands

Integrally Survey of N.S.W.

RECONNAISSANCE and MAINTENANCE REPORT 0212

STATION **PODGERS (P) T.S.**

This Trig. Station has been:

Note: Cross out word or words which do not apply

Co: **COOK** Ph: _____ No: _____
 Map Sheet: _____
 Inspected by: **L.M HAYES** Date: **Dec 1976**
 Authority: **Dept of Lands** Field Book: **PP 796 801**
 Beacon Diagram: _____ Not to Scale

1. Completely cleared to permit 360° vision to surrounding Trigs.

2. Cleared by lanes bearing _____ from Trig. Mast

3. Trig. Mast & Vanes have been painted white & black respectively.

4. The Trig. was unpiled/not unpiled, dimensions now being: **5.0**

Description of mark: ~~stone~~ **steel** ~~be~~ **explicit**, e.g. Steel plug, Brass plug, Bolt, Concrete Pillar

Height of mark: _____ m ^{above} rock/concrete _____ m ^{above} G.L.

Height of Top Vanes to Top Mark/Top pillar plate: _____ m Diameter of Vanes (vertical): _____ m.

Height of Cairn: _____ m. Diameter of Cairn: _____ m.

Length of Mast: _____ m. (approximate if not unpiled)

5. A **NAIL** set in conc/rock has been placed/rd **105.26m**, bearing **21** °M from Trig. Mast/pillar

6. A **Star Picket** set in conc/rock has been placed/rd **104.39m**, bearing **26** °M from Trig. Mast/pillar

7. A _____ set in conc/rock has been placed/rd _____ m, bearing _____ °M from Trig. Mast/pillar

8. A _____ set in conc/rock has been placed/rd _____ m, bearing _____ °M from Trig. Mast/pillar

9. Connection: **NAIL** to **Star Picket** **8.723m**, bearing **119** °M

10. Connection: _____ to _____ m, bearing _____ °M

11. Connection: _____ to _____ m, bearing _____ °M

12. Connection: **NAIL** to _____ m, bearing _____ °M

13. Diff. Ht. _____ is _____ m, ^{above} **Pillar Plate**

14. Diff. Ht. _____ is _____ m, ^{above} **Star Picket**

15. Diff. Ht. _____ is _____ m, ^{above} _____

16. Diff. Ht. _____ is _____ m, ^{above} _____

AS PER PREVIOUS CARD

Date	Record of Station
	See previous card also.


Prepared by: **L. HAYES**

Checked: _____

STATION **PODGERS (P) TS 10212**

Owners Name.....
 Current Occupant.....
 Address.....
 Address.....
 Access.....

AS PER PREVIOUS CARD.

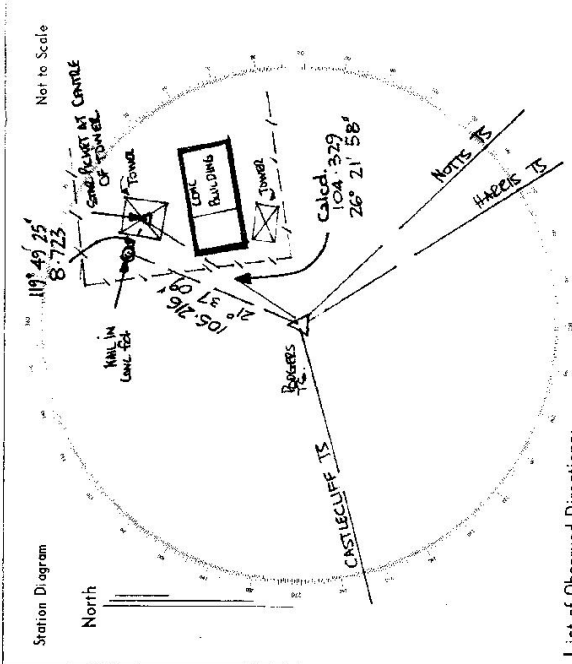

List of Observed Directions:-

Standpoint: RILBY		Standpoint: NAIL IN CONC.	
Station	Direction	Station	Direction
NORTS TS	197° 00' 00"	PODGERS	6° 00' 00"
HARRIS TS	148° 40' 16"	CASTLECLIFF TS	56° 35' 02"
CASTLECLIFF TS	258° 50' 48"	PODGERS TOWER	278° 12' 16"
NAIL	21° 37' 09"		
CENTRE TOWER (NAIL IN CONC.)	26° 24' 34"		
STRACKET AT TOWER CENTRE.			
Station	Direction	Station	Direction
NAIL MODULA TS	0° 00' 00"		
KOUKA TS	18° 55' 41"		
NAIL IN CONC.	344° 08' 04"		

