

STATION NOTTS (P) TS 10213


Owners Name.....
 Current Occupant.....
 Address.....
 Address.....

DELIVERABLE IN CONVENTIONAL VEHICLE

Access June 1975
 0.00 MILES INTSN GT WESTERN HIGHWAY AND TABLELAND ROAD. BRADINGTON
 SIGNPOSTED McMAHONS LOOKOUT, ACCESS TO TOWER 2100 - 2179"
 TAKE TABLELANDS CO TOWARDS McMAHONS LOOKOUT
 2.50 MILES TAKE LEFT HAND FORK (QUEEN VICTORIA MEMORIAL HOSPITAL ON RIGHT)
 2.6 MILES END PITMEN CONTINUE ON GRATEL ROAD

NB. THESE FEATURES VISIBLE ALONG TRACK

2.8 MILES TANK ON RIGHT
 6.7 MILES TOLG VISIBLE
 6.95 MILES TANK ON LEFT
 7.00 MILES LENE VEHICLE IN SIGHT CLOSING ON LEFT OF TANK
 APPROX 10 MINUTE WALK UP HILL TO TOLG.

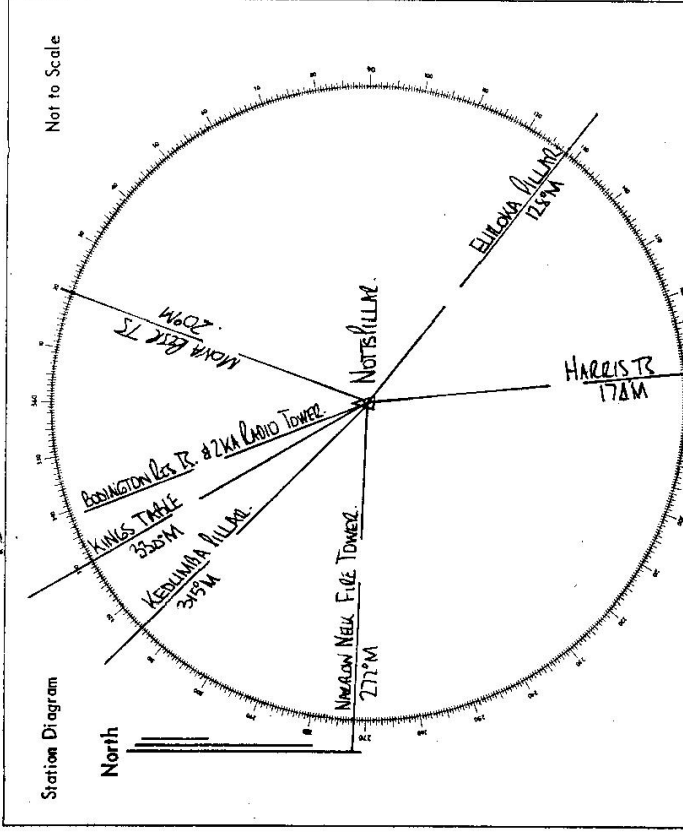

List of Observed Directions:-

Station	Direction	Station	Direction
MT Harris TS	090°00"		
Kedumba TS	172°59'03"		
Kings Table TS	156°59'44"		
Bradington TS	168°15'01.3"		
Mona TS	208°05'18.6"		
Eureka TS	318°28'58.6"		