

STATION TS 10229 DOYLES [P]


Current Occupant.....

Address.....

Owners Name: Neil Duncan

Address: Warri's Creek


Access 24-11-1979

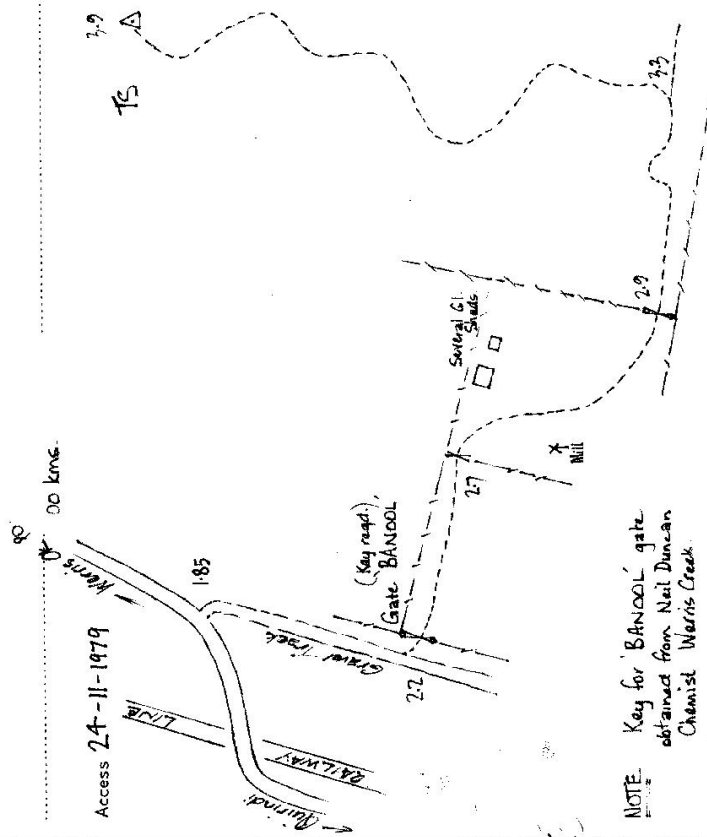

NOTE: Key for 'BANNOOL' gate obtained from Neil Duncan Chemist Warri's Creek.
4 WD ACCESS.

D. West, Government Printer, New South Wales - 1976

Not to Scale

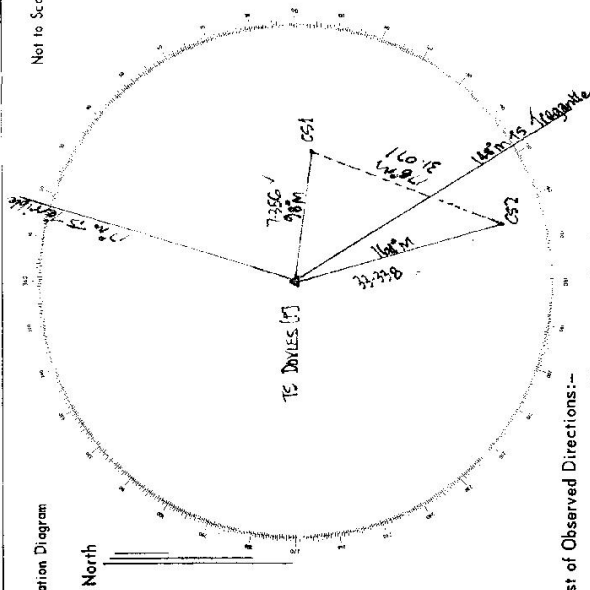

List of Observed Directions:-

Station	Direction	Station	Direction
TS Terrible	148° 00' 00"	TS Terrible	0° 00' 00"
TS Grenfell	224° 14' 24.9"	TS DOYLES [P]	325° 23' 35"
TS Ganga	304° 51' 17.4"	CS1	337° 53' 13.9"
TS Terrible	17° 51' 45.7"		
TS DOYLES CS1	97° 12' 09.4"		
TS DOYLES CS2	163° 06' 04.4"		

Standpoint: TS DOYLES [P] Standpoint: CS2