


STATION **BOCOBLE** /023

Current Occupant... **COMMONWEALTH**

Owners Name.....


Address.....

MILEAGE	FEATURE
0.0	At CUPASICONS Creek bridge. Map ref. 279 944.
	Take road towards Mullagez.
4.8	Left turn over grid onto dirt road.
	Sign "LIMESONE FLAT"
6.1	Take right fork
9.5	Gate
10.1	Gate
10.6	Turn left
13.6	Grid
14.1	Turn left after bridge
14.5	Grid
14.9	Turn left onto Ford. Sign "COMMONWEALTH PROPERTY"
15.2	Locked gate
15.8	Locked gate
16.3	Left along stockyard
17.3	Trig

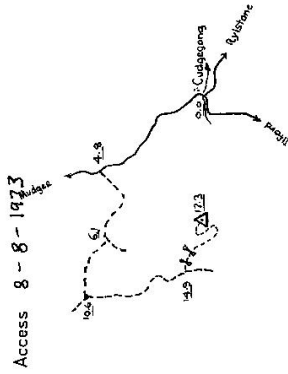

Note: Two locked gates on access road. Keys available ridge and must be driven to by normal vehicle.

Station Diagram

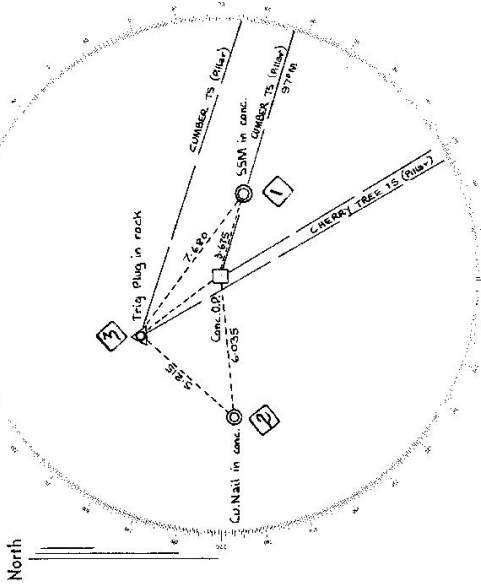

List of Observed Directions:-

Station	Direction	Station	Direction
CUMBER TS (Pillar)	155° 59'	CUMBER TS (Pillar)	305° 59'
CHERRY TREE TS (Pillar)	42° 23'	SSM in conc.	19° 07'
Trig Plug in rock	215° 27'	Pillar Plug	35° 28'
SSM in conc.	359° 24'	CHERRY TREE TS (Pillar)	42° 22' 30"
Cu Nail in conc.	159° 02'	Cu Nail in conc.	112° 44'

Standpoint: Trig Plug in rock

Station	Direction	Station	Direction
CUMBER TS (Pillar)	155° 59'	CUMBER TS (Pillar)	305° 59'
CHERRY TREE TS (Pillar)	42° 23'	SSM in conc.	19° 07'
Trig Plug in rock	215° 27'	Pillar Plug	35° 28'
SSM in conc.	359° 24'	CHERRY TREE TS (Pillar)	42° 22' 30"
Cu Nail in conc.	159° 02'	Cu Nail in conc.	112° 44'

CENTRAL MAPPING AUTHORITY

GEODETTIC SURVEY OF N.S.W.


GEODETTIC STATION RECONNAISSANCE and MAINTENANCE REPORT

STATION: **BOCOBLE (P)** No.: **1023**

MAP SHEET SCALE 1:250 000
INSPECTED BY: **P. NAYLOR** DATE: **27.8.79**

AUTHORITY: **C.M.A.** FIELD BOOK:

DUBBO

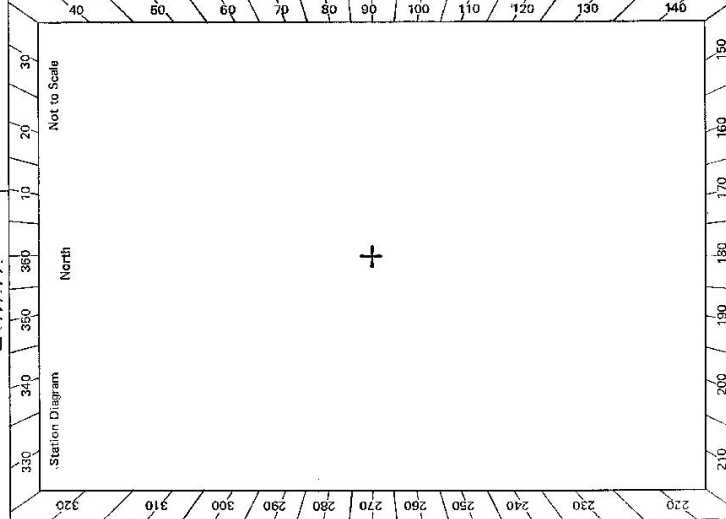


- Description:
- Cleared by lanes bearing.....
Note: Cross out word or words which do not apply
 - Mast & Vanes have been painted white & black respectively. ✓
from Trig. Mast
 - The station/pillar was ~~erected~~ ^{erected} on **2.7.8.** dimensions now being: **19.70**
Description of mark.....should be explicit, e.g., S/Steel Pillar Plate, Steel plug, Brass plug, Bolt, G.I. Pipe
Height of mark.....**1.37** m. ^{above} ~~below~~ ^{concrete} Mark is **1.47** m. ^{above} G.L.
Height of Top Vanes to ~~Top~~ ^{Top} Mark/Pillar plate **1.435** m. Diameter of Vanes (vertical) **0.905** m.
Height of Cairn..... m. Diameter of Cairn..... m. Name Plate found ~~not found~~ ^{found}
 - Length of Mast..... m. (approximate if not unplied)
 - A..... set in conc/rock has been placed/found, bearing.....° M from Mast/Plug/Pillar
 - A..... set in conc/rock has been placed/found, bearing.....° M from Mast/Plug/Pillar
 - A..... set in conc/rock has been placed/found, bearing.....° M from Mast/Plug/Pillar
 - A..... set in conc/rock has been placed/found, bearing.....° M from Mast/Plug/Pillar
 - Action required:.....

STANDPOINT:			
Mark	Direction	Horiz. Distance	Height Difference
			above standpt.
			below standpt.
			above standpt.
			below standpt.
Prepared by: **P. Naylor** 3/8/79. Checked: **14/3/81** Noted on U.T.M. Card

Sr 2753-2 D. West, Government Printer

STATION **BOCOBLE (P) 1023**

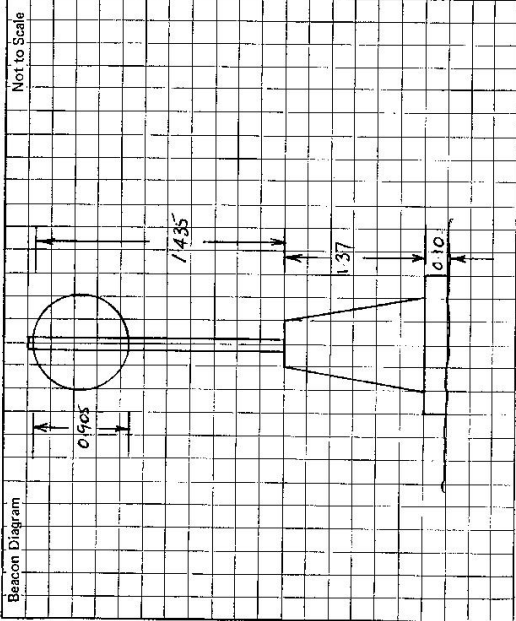

Owner's Name:
 Address:
 Phone:

Current Occupant:
 Address:
 Phone:

ACCESS
 Access Report of 27/8/1973 was found suitable/unsuitable.

This section to be completed by officer constructing pillar.

Original station mark found/not found.

Description of mark:

Original beacon found/not found.

Description of beacon:

Height Top of Vanes to Top Mark.....m.

Height of mark.....m. above G.L. below

Diameter of Vanes.....m. Height of Cairn.....m.

Original Beacon has/has not been destroyed by me.

Date	Record of Station
27.8.79	Verification of beacon dimensions by Comptrol Division

CENTRAL MAPPING AUTHORITY

GEODETIC SURVEY OF M.S.W.
 GEODETIC STATION RECONNAISSANCE and MAINTENANCE REPORT

- Description: *Note: Cross out word or words which do not apply*
1. Cleared by lanes bearing..... from Trig. Mast
 2. Mast & Vanes have been painted white & black respectively.
 3. The station/pillar was unplied/not unplied/constructed on..... 19....., dimensions now being:
 Description of mark..... should be explicit, e.g. S/Steel Pillar Plate; Steel plug, Brass plug, Bolt, G.I. Pipe
 Height of mark.....^{above} m. ^{below} m. Mark is.....^{above} m. ^{below} G.L.
 Height of Top Vanes to Top Mark/Pillar plate..... m. Diameter of Vanes (vertical)..... m.
 Height of Cairn..... m. Diameter of Cairn..... m. Name Plate found/not found/placed.
 Length of Mast..... m. (approximate if not unplied)
 4. A..... set in conc/rock has been placed/found, bearing..... °M from Mast/Plug/Pillar
 5. A..... set in conc/rock has been placed/found, bearing..... °M from Mast/Plug/Pillar
 6. A..... set in conc/rock has been placed/found, bearing..... °M from Mast/Plug/Pillar
 7. A..... set in conc/rock has been placed/found, bearing..... °M from Mast/Plug/Pillar
 8. Action required:.....

STANDPOINT:

Mark	Direction	Horiz. Distance	Height Difference	Mark	Direction	Horiz. Distance	Height Difference
			above standpt				above standpt
			below				below
			above standpt				above standpt
			below				below
Prepared by: *[Signature]* Checked: *[Signature]*

Noted on U.T.M. Card

STATION: **BOCOBLE** No.: **1023**
 MAP SHEETS SCALE 1:250 000
 INSPECTED BY: **I. Robbins** DATE: **17/7/86**
 AUTHORITY: **C.M.A** FIELD BOOK:

Station Diagram
 330 340 350 360 370 380 390 400 410 420 430 440
 North
 Not to Scale

*New Access Only
 See over page*

+

210 200 190 180 170 160 150 140
 240 250 260 270 280 290 300 310 320
 Checked

GS 24

<p>Beacon Diagram</p> <p style="text-align: right;">Not to Scale</p>	<p>NB Key required see access</p>	<p>STATION BOCOBLE 1023</p>	<p>Owner's Name: Commonwealth Property Address: C/- Telephone Exchange Phone: Mudgee</p> <p>Current Occupant: Address: Phone:</p> <p style="text-align: center;">ACCESS</p> <p>Km Access Report of 17.7.1986 was found suitable/unstable. 00 At Soda turn off at Herd on Lithgow Mudgee Road head north 9.3 Pass turn off to Rylstone & Kahades to right 10.4 Pass Crudine turn off to left 13.1 At Arons Pass (top of hill) turn off to left to Pyramid 22.9 Turn right to BocoBLE: Road continues st. ahead to Sally's Flat 23.1 GROSS Grid 23.7 GROSS Grid 24.2 Cross causeway 26.7 After crossing 2 grids turn right (Campbells Cr SP to left) 32.1 After crossing 4 grids x 2 causeway turn right into Woorawong Road & cross culvert immediately 33.5 locked gate: Key from PMS, Post Office Mudgee or Elcom bay SSI required 35.7 BocoBLE GS. Conventional vehicle may be used in all weathers.</p>
<p>This section to be completed by officer constructing pillar.</p> <p>Original station mark found/not found.</p> <p>Description of mark:</p> <p>Original beacon found/not found.</p> <p>Description of beacon:</p> <p>Height Top of Vanes to Top Markm.</p> <p>Height of mark:m. above G.L. below G.L.</p> <p>Diameter of Vanesm. Height of Cairnm.</p> <p>Original Beacon has/has not been destroyed by me.</p>		<p>Date</p> <p>Record of Station</p>	