

75-10.9

Department of Lands

Integrative Survey of N.S.W.

RECONNAISSANCE and MAINTENANCE REPORT

MARK WORTH 2 (P) STATION

TS 10232

This Trig. Station has been:-

Note: Cross out word or words which do not apply

1. Completely cleared to permit 360° vision to surrounding Trigs.

2. Cleared by lanes bearing

3. Trig. Mast & Vanes have been painted white & black respectively. ✓

4. The Trig. was unpiled/~~not unpiled~~, dimensions now being:

Description of mark: ~~STEEL PILLAR~~ ^{rock} ~~concrete~~ should be explicit, e.g. Steel plug, Brass plug, Bolt, Concrete Pillar

Height of mark: 1.36 m ^{above} ~~below~~ ~~concrete~~ ^{rock} ~~concrete~~ 1.41 m ^{above} ~~below~~ G.L.

Height of Top Vanes to ~~Top Mark~~ Top pillar plate 1.44 m Diameter of Vanes (vertical) 0.6 m.

Height of Cairn 1.36 m. Diameter of Cairn

Length of Mast 1.53 m. (approximate if not unpiled)

5. A. set in conc/rock has been placed/fd m. bearing °M from Trig. Mast/pillar

6. A. set in conc/soil has been placed/fd m. bearing °M from Trig. Mast/pillar

7. A. set in conc/soil has been placed/fd m. bearing °M from Trig. Mast/pillar

8. A. set in conc/rock has been placed/fd m. bearing °M from Trig. Mast/pillar

9. Connection to m. bearing °M

10. Connection to m. bearing °M

11. Connection to m. bearing °M

12. Connection to m. bearing °M

13. Diff. Ht. is m. ^{above} ~~below~~

14. Diff. Ht. is m. ^{above} ~~below~~

15. Diff. Ht. is m. ^{above} ~~below~~

16. Diff. Ht. is m. ^{above} ~~below~~

Prepared by: B.S. COLLIER

Checked: J.J. COLLIER


Co: HUNTER

Map Sheet: ~~PSA 604~~ 1:100 000

Inspected by: B.S. COLLIER

Authority: ~~Integration Surveys~~

Beacon Diagram

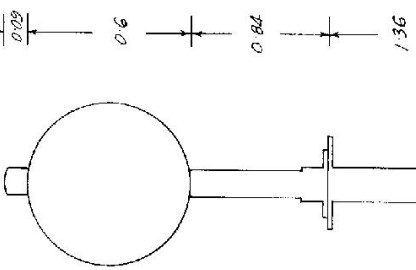

No: 9132

Date: 30.8.76

Field Book: PDP 746

Not to Scale

Date

30.8.76

PILLAR MARKED

Record of Station

STATION MARK: RTH 2 (P) TS 10232

Owners Name: Current Occupant:

Address: Address:

Access 30-8-1976

TAKE PUTTY ROAD FROM SINGLETON
 TRAVEL APPROX 11.7 KM FROM SINGLETON
 TURN RIGHT ALONG ROAD TO JERRY'S PLAINS
 TURN LEFT THROUGH GATE 7.6 KM FROM PUTTY ROAD
 FOLLOW UP RIDGE 200 M TO PILLAR ON TOP OF KNOLL

