

76.18.4


Department of Lands  
 Integrative Survey of N.S.W.  
 RECONNAISSANCE and MAINTENANCE REPORT 10233 STATION WARKWORTH 3 (N) TS 10233

This Trig. Station has been:-  
 Note: Cross out words which do not apply  
 1. Completely cleared to permit 360° vision to surrounding Trigs.  
 2. Cleared by lanes bearing  
 3. Trig. Mast & Vanes have been painted white & black respectively. ✓  
 4. The Trig. was unpiled / not unpiled - dimensions now being:

Description of mark: STEEL PILLAR should be explicit, e.g. Steel plug, Brass plug, Bolt, Concrete Pillar  
 Height of mark: 1.28 m above rock concrete 1.33 m above G.L.  
 Height of Top Vanes to Top Mast: 1.44 m Diameter of Vanes (vertical): 0.6 m.  
 Height of Cairn: 1.28 m. Diameter of Cairn: \_\_\_\_\_ m.  
 Length of Mast: 1.53 m. (approximate if not unpiled)

5. A set in conc/rock has been placed/rd \_\_\_\_\_ m. bearing \_\_\_\_\_ °M from Trig. Mast/pillar  
 6. A set in conc/soil has been placed/rd \_\_\_\_\_ m. bearing \_\_\_\_\_ °M from Trig. Mast/pillar  
 7. A set in conc/soil has been placed/rd \_\_\_\_\_ m. bearing \_\_\_\_\_ °M from Trig. Mast/pillar  
 8. A set in conc/rock has been placed/rd \_\_\_\_\_ m. bearing \_\_\_\_\_ °M from Trig. Mast/pillar  
 9. Connection to \_\_\_\_\_ : \_\_\_\_\_ m. bearing \_\_\_\_\_ °M  
 10. Connection to \_\_\_\_\_ : \_\_\_\_\_ m. bearing \_\_\_\_\_ °M  
 11. Connection to \_\_\_\_\_ : \_\_\_\_\_ m. bearing \_\_\_\_\_ °M  
 12. Connection to \_\_\_\_\_ : \_\_\_\_\_ m. bearing \_\_\_\_\_ °M  
 13. Diff. Ht. \_\_\_\_\_ is \_\_\_\_\_ m. above/below  
 14. Diff. Ht. \_\_\_\_\_ is \_\_\_\_\_ m. above/below  
 15. Diff. Ht. \_\_\_\_\_ is \_\_\_\_\_ m. above/below  
 16. Diff. Ht. \_\_\_\_\_ is \_\_\_\_\_ m. above/below

Prepared by: B.S. COLLIER Checked: B.S. COLLIER  
 Date: 10-8-76 PILLAR PLACED  
 Record of Station

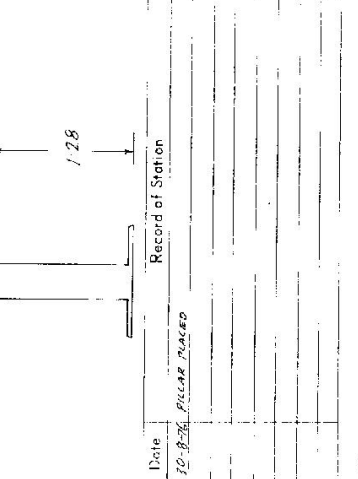

Map Sheet: CRANOCK 1:100 000 No: 9132  
 Inspected by: B.S. COLLIER Date: 31.8.76  
 Authority: Integration Survey Field Book: POP 742

