



STATION *MARKWORTH & P. (P)* TS 10234


Owners Name..... Current Occupant.....

Address..... Address.....

Access **31-8-1976**

TAKE PUTTY ROAD FROM SINGLETON  
 TRAVEL APPROX 11.7 KM FROM SINGLETON  
 TURN RIGHT ALONG ROAD TO JERRY'S PLAINS  
 TURN RIGHT 2.1 KM FROM PUTTY ROAD ALONG ROAD TO GOWDSVILLE  
 FOLLOW ROAD 3.3 KM TO PILLAR NEAR OLD RUIN

Station Diagram Not to Scale

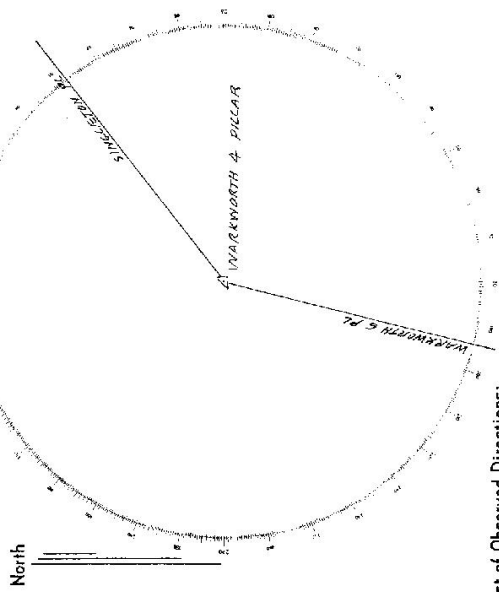

List of Observed Directions:-

Standpoint: PILLAR		Standpoint:	
Station	Direction	Station	Direction
SINGLETON PL	0° 00' 00"		
MARKWORTH & P.	142° 55' 14"		
Station	Direction	Station	Direction

D. West, Government Printer, New South Wales - 1976




© Other than for the purpose of research or fair dealing no part of this data may be reproduced by any means without prior written permission.

**LOCALITY SKETCH PLAN**

PM T.S 10234  
SSM WARKWORTH 4  
 Description .....

Parish ..... County ..... Town/Suburb/Locality .....  
 Local Government Area ..... LIC Map Sheet .....

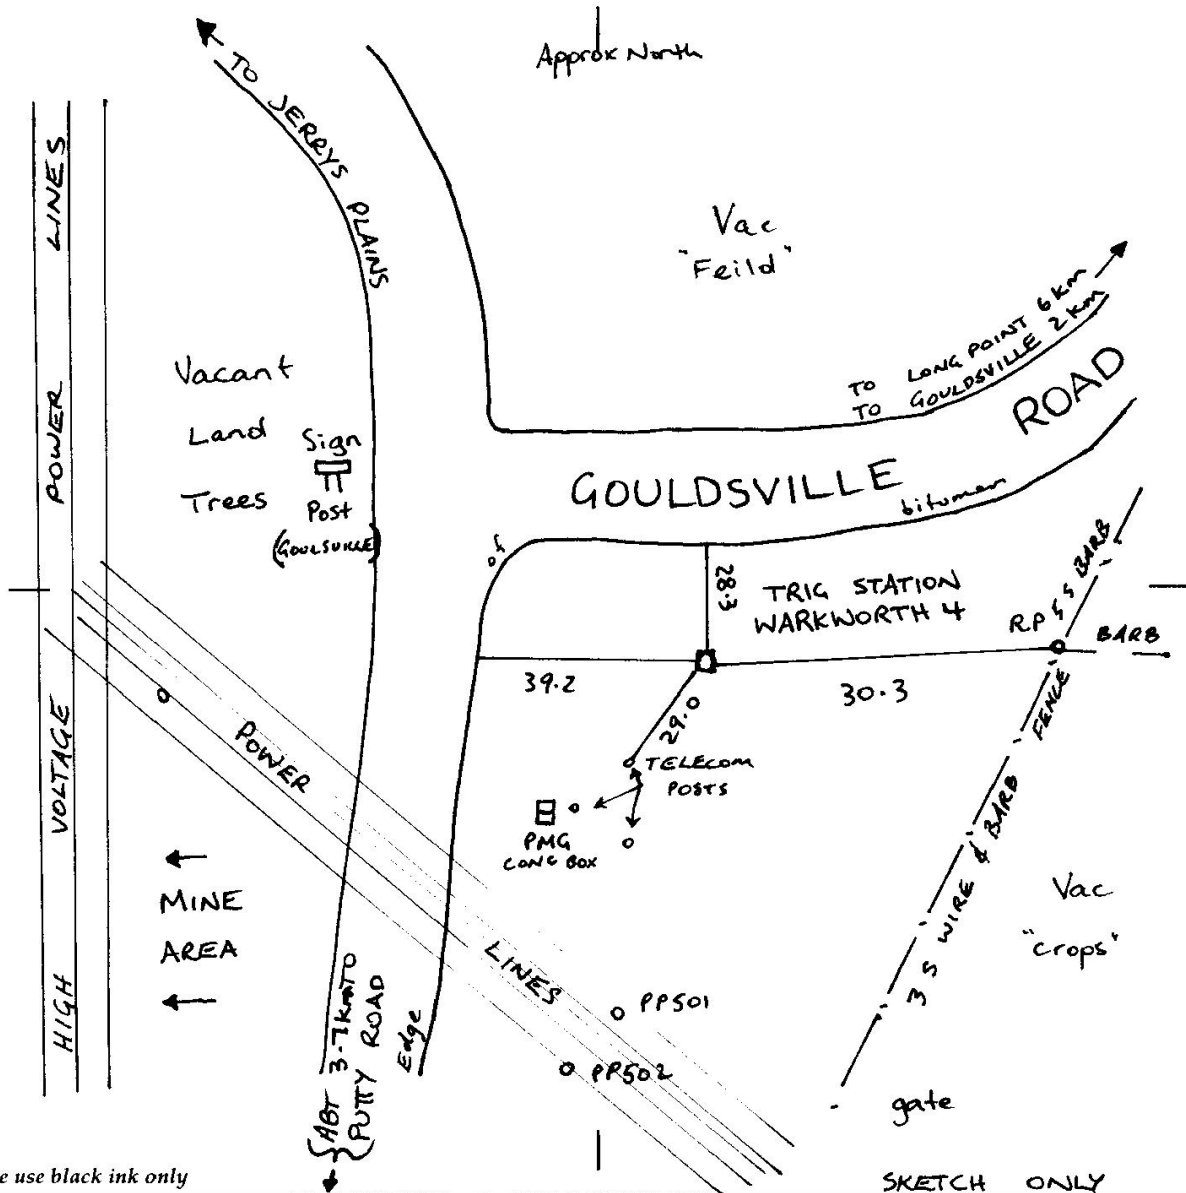

Please use black ink only

SKETCH ONLY

SURVEY PRACTICE REGULATION			1990
MARK	AHD	SOURCE	DATE
HEIGHT DETERMINED BY DIFF. LEVELLING (specify)			TRIG. HEIGHTING
ADOPTED MARKS			

Measurements are in metres

I certify that the Mark or Marks have been placed and numbered as detailed hereon

PM T.S 10234  
SSM WARKWORTH 4

Signed A. Holt  
 Mark placed 8/3/96

Replaces PM ..... Organization placing marks L.I.C N/CLE  
 SSM ..... Ref .....