

STATION MARKA TH 5 (P) TS 10235

Owners Name.....


Current Occupant.....

Address.....

Address.....

Access 31-8-1976

TAKE PUTTY ROAD FROM SINGLETON
 TRAVEL APPROX 117KM FROM SINGLETON
 TURN RIGHT ALONG ROAD TO JERRY'S PLAINS
 TURN LEFT THROUGH GATE 6.5 KM FROM PUTTY ROAD
 FOLLOW FENCE 200M TO PILLAR

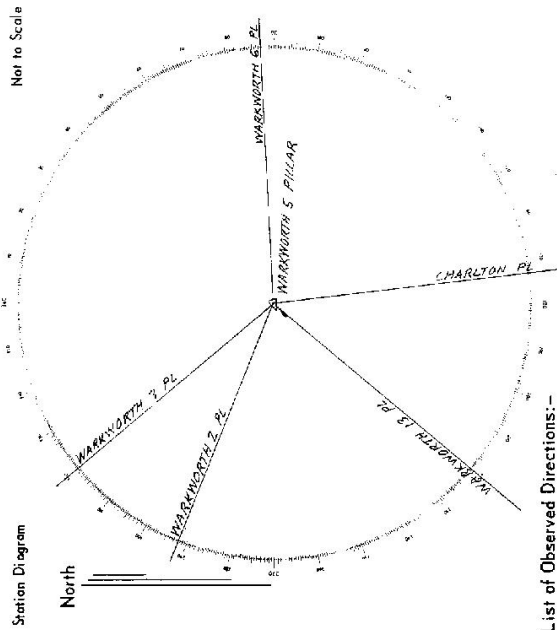

List of Observed Directions:-

Standpoint: PILLAR		Station	
Station	Direction	Station	Direction
CHARLTON PL	0° 00' 00"		
MARKNORTH 1 PL	46° 32' 03"		
MARKNORTH 2 PL	18° 40' 10"		
MARKNORTH 3 PL	144° 26' 213"		
MARKNORTH 6 PL	274° 51' 56.5"		
Station	Direction	Station	Direction