

75 103


Department of Lands

Integrating survey of N.S.W. RECONNAISSANCE and MAINTENANCE REPORT 10241

STATION MARK NORTH 11 (P) JS 10241
Co: NORTUMBERLAND Ph: WOLLUMBOI

Map Sheet: CESSNOCK 1:100 000 No: 9132
Inspected by: B.S. Collier Date: 30.8.76
Authority: Integration Surveys Field Book: PP 764

This Trig. Station has been:-
1. Completely cleared to permit 360° vision to surrounding Trigs.
2. Cleared by James bearing from Trig. Mast
3. Trig. Mast & Vanes have been painted white & black respectively.
4. The Trig. was unpiled/~~not replaced~~ dimensions now being:
Description of mark..... STEEL PILLAR should be explicit, e.g. Steel plug, Brass plug, Bolt, Concrete Pillar
Height of mark..... 1.28 m above rock concrete 1.33 m above G.L.
Height of Top Vanes to ~~Top Mast~~ Top pillar plate..... 1.44 m Diameter of Vanes (vertical)..... 0.5 m.
Height of Cairn..... 1.28 m. Diameter of Cairn..... m.
Length of Mast..... 1.53 m. (approximate if not unpiled)

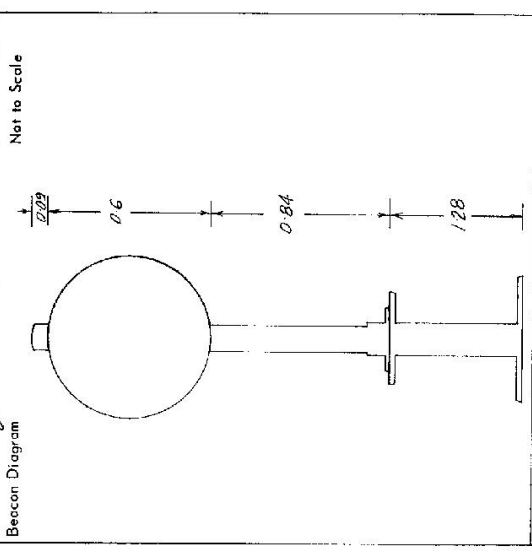

- 5. A..... set in conc/rock has been placed/fd m. bearing°M from Trig. Mast/pillar
- 6. A..... set in conc/soil has been placed/fd m. bearing°M from Trig. Mast/pillar
- 7. A..... set in conc/soil has been placed/fd m. bearing°M from Trig. Mast/pillar
- 8. A..... set in conc/rock has been placed/fd m. bearing°M from Trig. Mast/pillar
- 9. Connection..... to..... m. bearing.....°M
- 10. Connection..... to..... m. bearing.....°M
- 11. Connection..... to..... m. bearing.....°M
- 12. Connection..... to..... m. bearing.....°M
- 13. Diff. Ht. is..... m. above below
- 14. Diff. Ht. is..... m. above below
- 15. Diff. Ht. is..... m. above below
- 16. Diff. Ht. is..... m. above below

Date	Record of Station
30-8-76	B.S. COLLIER


Prepared by: B.S. COLLIER Checked: A. Sullivan

STATION MARKING (H/P) TS 10241

Owners Name..... Current Occupant.....

Address..... Address.....

Access 30-8-1976
 TAKE PUTTY ROAD FROM SINGLETON
 TRAVEL SOUTH APPROX 17.1 KM FROM SINGLETON
 TURN RIGHT INTO ROAD TO WARRNORTH
 TURN LEFT THROUGH GATE MARKED 'LAUREL BR' 1 KM FROM PUTTY ROAD
 FOLLOW TRACK 0.7 KM TO GATE
 PILLAR 200M THROUGH GATE

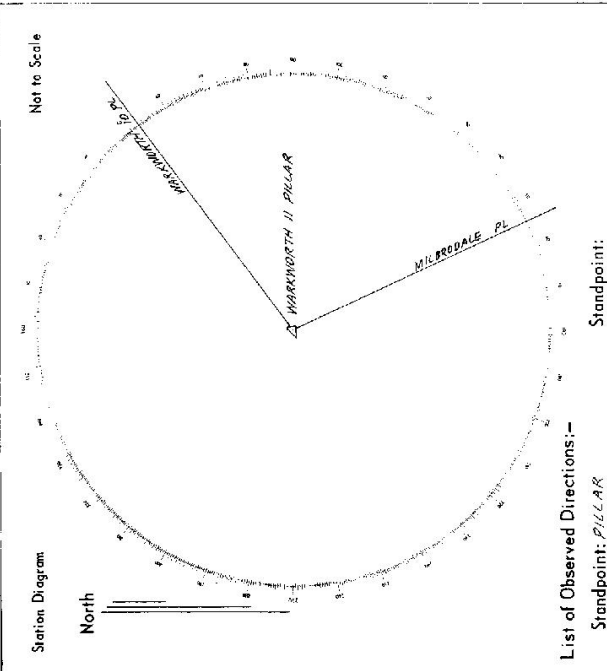

List of Observed Directions:-

Standpoint: PILLAR		
Station	Direction	Station
MILBRODALE PL	0° 00' 00"	
WARRNORTH II PILLAR	257° 57' 41"	
Station	Direction	Station