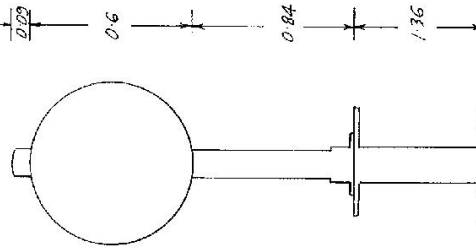


7/10/22

Department of Lands Integratic Survey of N.S.W. RECONNAISSANCE and MAINTENANCE REPORT 10242	STATION WARRIMUR 12 (P) TS 10242 Co: HUNTER Ph: WARRIMUR Map Sheet: CASSINOCK 1:100 000 No: 9132 Inspected by: BS. Collier Date: 30.8.76 Authority <u>Integration Surveys</u> Field Book: PD0746	This Trig. Station has been:- <ol style="list-style-type: none"> 1. Completely cleared to permit 360° vision to surrounding Trigs. 2. Cleared by lanes bearing..... from Trig. Mast 3. Trig. Mast & Vanes have been painted white & black respectively. ✓ 4. The Trig. was unpiled/not unpiled, dimensions now being: Description of mark STEEL PILLAR should be explicit, e.g. Steel plug, Brass plug, Ball, Concrete Pillar Height of mark.....m above horizontal rock concretem above horizontal G.L. Height of Top Vanes to Top plate Top pillar platem Diameter of Vanes (vertical) 0.5.....m. Height of Cairn.....m. Diameter of Cairn.....m. Length of Mast 1.53.....m. (approximate if not unpiled) <ol style="list-style-type: none"> 5. A.....set in conc/rock has been placed/id.....m. bearing.....°M from Trig. Mast/pillar 6. A.....set in conc/soil has been placed/id.....m. bearing.....°M from Trig. Mast/pillar 7. A.....set in conc/soil has been placed/id.....m. bearing.....°M from Trig. Mast/pillar 8. A.....set in conc/rock has been placed/id.....m. bearing.....°M from Trig. Mast/pillar 9. Connection.....to.....m. bearing.....°M 10. Connection.....to.....m. bearing.....°M 11. Connection.....to.....m. bearing.....°M 12. Connection.....to.....m. bearing.....°M 13. Diff. Ht. is.....fr. ^{above}/_{below} 14. Diff. Ht. is.....m. ^{above}/_{below} 15. Diff. Ht. is.....m. ^{above}/_{below} 16. Diff. Ht. is.....m. ^{above}/_{below} Prepared by: BS. COLLEA Checked: PD Beacon Diagram  Not to Scale Date 30.8.76 PILLAR PLACED Record of Station
--	--	--

STATION *WARREN TH 12 (P)* TS **10242**


Owners Name.....
 Current Occupant.....
 Address.....
 Address.....

Access **30-8-1976**

TAKE PUTTY ROAD FROM SINGLETON
 TRAVEL APPROX 17.1 KM SOUTH FROM SINGLETON
 TURN RIGHT INTO ROAD TO WARKWORTH
 TURN RIGHT THROUGH GATE 2.8 KM FROM PUTTY ROAD
 FOLLOW UP RIDGE APPROX 400M TO PILLAR ON KNOLL

Station Diagram

North

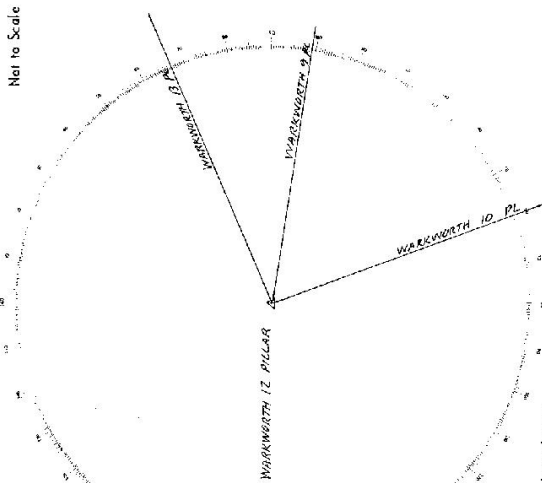

List of Observed Directions:-

Standpoint: *PILLAR*

Station	Direction	Station	Direction
WARKWORTH 13 PL	0° 00' 00"		
WARKWORTH 9 PL	32° 22' 29.3		
WARKWORTH 10 PL	93° 17' 29.4		
Station	Direction	Station	Direction