

75-16

Department of Lands Integration of N.S.W. RECONNAISSANCE and MAINTENANCE REPORT to 2025 STATION AUBURN HOSPITAL PILLAR

This Trig. Station has been:-  
 Note: Cross out word or words which do not apply

1. Completely cleared to permit 360° vision to surrounding Trigs.  
 2. ~~Cleared by James bearing~~ from Trig-Mast  
 3. Trig. Mast & Vanes have been painted white & black respectively.  
 4. The Trig. ~~was omitted not omitted~~, dimensions now being:

Description of mark Steel Pillar should be explicit, e.g. Steel plug, Brass plug, Balr, Concrete Pillar  
 Height of mark 1.35 m <sup>above</sup> ~~below~~ rock/concrete ..... m above below G.L.  
 Height of ~~Top Vane to Top pillar plate 62.47~~ Aff.Dm Diameter of Vanes (vertical) 0.60 .m.

Height of Cairn ..... m. Diameter of Cairn ..... m.  
 Length of Mast 1.485 m. (approximate if not upiled)

5. A ~~Tri~~ <sup>Nail</sup> set in conc/rock has been placed at 4.482m bearing 76° 09' <sup>T</sup> from Trig. Mast/pillar  
 6. A do set in conc/rock has been placed at 10.045m bearing 164° 50' <sup>T</sup> from Trig. Mast/pillar  
 7. A do set in conc/rock has been placed at 2.677m bearing 324° 15' <sup>T</sup> from Trig. Mast/pillar  
 8. A ~~do~~ set in conc/rock has been placed at ..... m bearing .....°M from Trig. Mast/pillar

9. Connection to ..... m. bearing .....°M  
 10. Connection to ..... m. bearing .....°M  
 11. Connection to ..... m. bearing .....°M  
 12. Connection to ..... m. bearing .....°M  
 13. Diff. Ht. is ..... m. <sup>above</sup> ~~below~~  
 14. Diff. Ht. is ..... m. <sup>above</sup> ~~below~~  
 15. Diff. Ht. is ..... m. <sup>above</sup> ~~below~~  
 16. Diff. Ht. is ..... m. <sup>above</sup> ~~below~~

Prepared by: \_\_\_\_\_ Checked: \_\_\_\_\_

Co: CUMBLELAND Ph: No: 0052  
 Map Sheet: PARRAMATTA  
 Inspected by: Date:  
 Authority: Field Book:

Beacon Diagram  
 Not to Scale




Date: 19 1 79 Record of Station  
 MEASUREMENTS FOR ABOVE DIAGRAM RECORDED

STATION AIRBURN HC TIAL FIGURE 10255


Owners Name.....  
 Current Occupant.....  
 Address.....

- Access
1. Entrance off Hargrave Rd.
  2. Key from Engineers Office ( near store )
  3. Take lift to 6th floor.
  4. Take stairs to 8th floor.
  5. Through locked door on western side.
  6. Up ladder.

Not to Scale

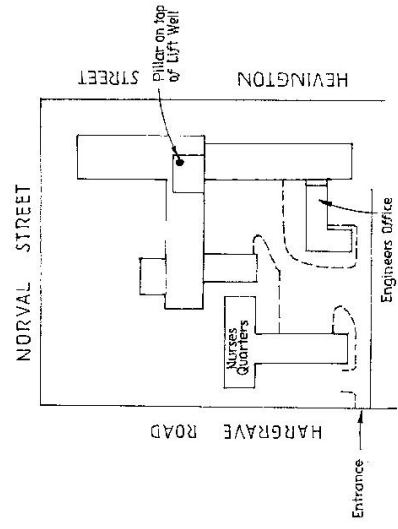

Station Diagram

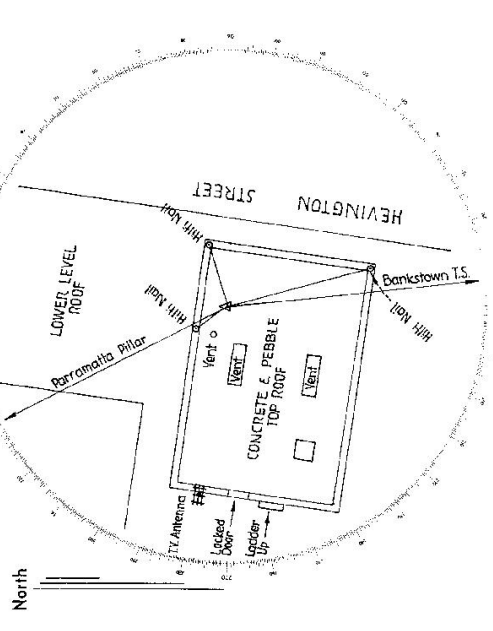

List of Observed Directions:-

Standpoint: Pillar		Standpoint:	
Station	Direction	Station	Direction
Bankstown T.S.		Ashfield T.S.	
Prospect Res.		Canarys T.S.	
Parramatta Pillar			
PM 12583			
PM 12581			
		PILLAR IS 1.79	
Station	Direction	Station	Direction
PM 12581		ASHFIELD	0° 00' 00"
		BANKSTOWN	41° 08' 58"
			303° 36' 11.6"