



STATION TS 10265 Mrs. MACQUARIES POINT (P)

TS 10265

Owners Name.....

Current Occupant.....


Address.....

Address.....

July 1978  
Conventional Vehicle

UAD Street Directory Map 2 E-1

Not to Scale

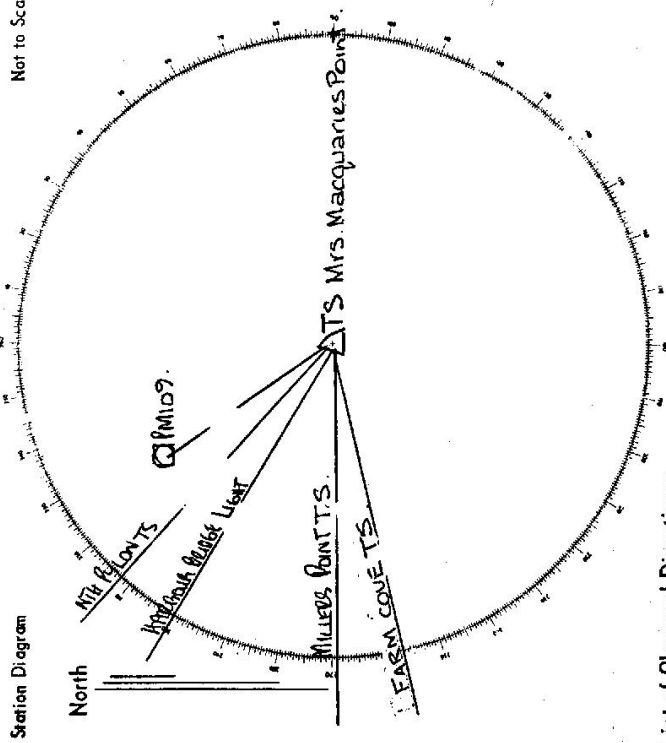

List of Observed Directions:-

Standpoint: R114

Standpoint:

Station	Direction	Station	Direction
MILKING SHED TS	270 00 00		
MILKING SHED LIGHT TS	300 07 56.5		
MILKING SHED TS	311 54 46.7		
MILKING SHED TS	325 29 08.1		
FARM COVE TS	257 19 17.7		

D. West, Government Printer, New South Wales - 1976