

CENTRAL MAPPING AUTHORITY  
Department of Lands

Trigonometrical Survey of N.S.W.

RECONNAISSANCE and MAINTENANCE REPORT

STATION KURE TS

10273

This Trig. Station has been:-

Note: Cross out word or words which do not apply

1. Completely cleared to permit 360° vision to surrounding Trigs.
2. Cleared by lanes bearing..... from Trig. Mast
3. Trig. Mast & Vanes have been painted white & black respectively.
4. ~~The Trig. was unspiled/not unspiled, dimensions ~~not being~~ ~~not found~~~~ ~~Station Mast found not found~~

Description of mark Cone. Pillar should be explicit, e.g. Steel plug, Brass plug, Bolt, G.I. Pipe

Height of mark..... m above rock/concrete..... m below G.L.

Height of Top Vanes to Top Mark..... m Diameter of Vanes (vertical)..... m.

Height of Cairn..... m Diameter of Cairn..... m.

Length of Mast..... m. (approximate if not unspiled)

5. A..... set in conc/rock has been placed..... m. bearing.....°M from Trig. Mast

6. A..... set in conc/soil has been placed..... m. bearing.....°M from Trig. Mast

7. A..... set in conc/soil has been placed..... m. bearing.....°M from Trig. Mast

8. A..... set in conc/rock has been placed..... m. bearing.....°M from Trig. Mast

9. Connection..... to..... m. bearing.....°M

10. Connection..... to..... m. bearing.....°M

11. Connection..... to..... m. bearing.....°M

12. Connection..... to..... m. bearing.....°M

13. Diff. Ht. .... is..... m. above below

14. Diff. Ht. .... is..... m. above below

15. Diff. Ht. .... is..... m. above below


16. Diff. Ht. .... is..... m. above below

Prepared by: Suby 2 4 10

Checked: Suby 2 4 10

Noted on U.T.M. Card

Co: Map Sheet: KATOOMBRA 1:3/680  
Inspected by: W. Munnell  
Authority: EMA  
Beacon Diagram: Not to Scale

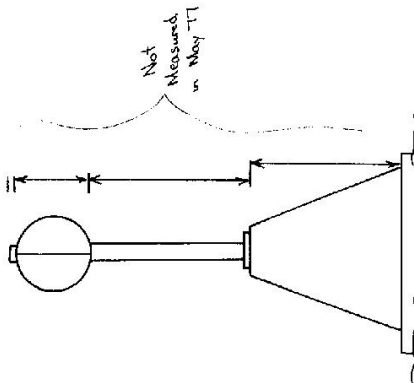

Date: Blue MTS Co. Council Table

Checked

