

75-10-1

Department of Lands Integrati Survey of N.S.W
RECONNAISSANCE and MAINTENANCE REPORT

STATION TS 10290C **WOONONA RES. (P)**
 Co: CAMDEN Ph: WOONONA
 Map Sheet: Wellingtons No: S823
 Inspected by: Date:
 Authority: MWS & DB Field Book:
 Beacon Diagram Not to Scale

This Trig. Station has been: Note: Cross out word or words which do not apply

1. Completely cleared to permit 360° vision to surrounding Trigs.
2. Cleared by lanes bearing from Trig. Mast
3. Trig. Mast & Vanes have been painted white & black respectively.
4. The Trig. was unpiled/not unpiled, dimensions now being:

ABSTRACT OF OBSERVATIONS

To	H. L. (metres)	Director or Vert. Angle	Variance	Observer	Date	D. st. in metres at M.S.L.	Variance	Ins.	Observer	Date
TICION WOONONA RES. R.L. 165.574 meters										
Reverse for Location agram	3.4									
	3.20									
	3.10									
	2.10									
	2.00									
B. 19379	1.30									
	1.17									
	0.53									
	0.02									
								Steel Platform	165.574	AHD

directions Corrected to centre All Vert's corrected ground to ground

SEE REAR OF CARD FOR REMARKS

15. Diff. Hr. is m. above m. below
16. Diff. Hr. is m. above m. below

Prepared by: Checked:


Date Record of Station

STATION WOONONA RES.10290 (P)

Owners Name: M.W.S.&D.B.
 Address: CNR. PITT. & BATHURST.
 S.T.S. SYDNEY

Current Occupant: M.W.S.&D.B.
 Address: CNR. PITT. & BATHURST.
 S.T.S. SYDNEY

Access 6-8-1079
 DIRECTION FROM PRINCES HWAY, BULLI, TURN WEST INTO HOSPITAL RD. BULLI N° 2 RES. LEFT HAND SIDE OF ROAD ACCESS TO TRIG. ON EASTERN EDGE OF RES. VIA STEEL LADDER.

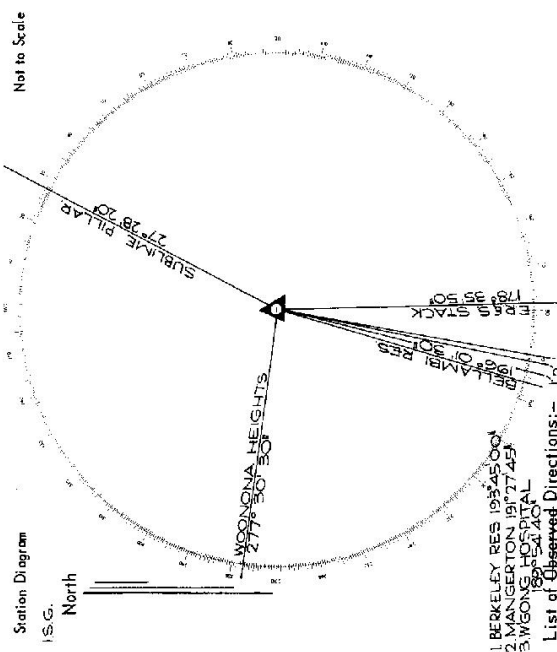

Standpoint: PILLAR EDGE RES. Standpoint: 172° 3'

Station	Direction	Station	Direction
BELLAMBI RES	191° 29' 00"		
WOONONA HEIGHTS	277° 30' 30"		
SUBURB PILLAR	27° 28' 20"		
E.R.S. STACK	342° 34' 00"		
WOLLONGONG HOSPITAL	353° 53' 10"		
MANGERTON	191° 27' 45"		
BERKELEY RES	193° 45' 00"		